


T.14S. R.15E.W.M.

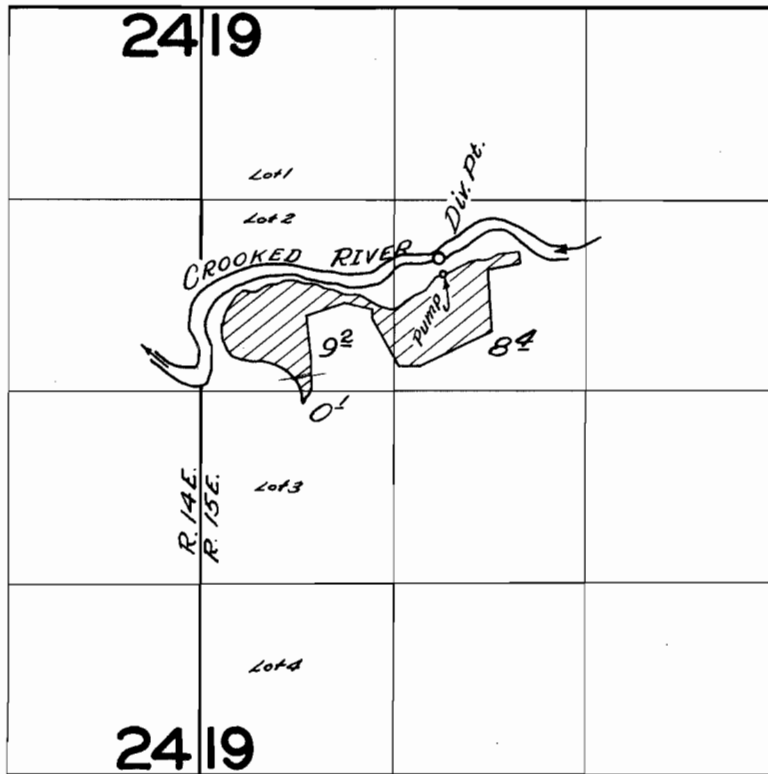

**FINAL PROOF SURVEY**  
UNDER

Application No. *25209* Permit No. *19815*  
IN NAME OF

*GEORGE SIGMAN*

Surveyed *July 30* 1957, by *C.O. Bartels*