



Range 26 E. W. M.

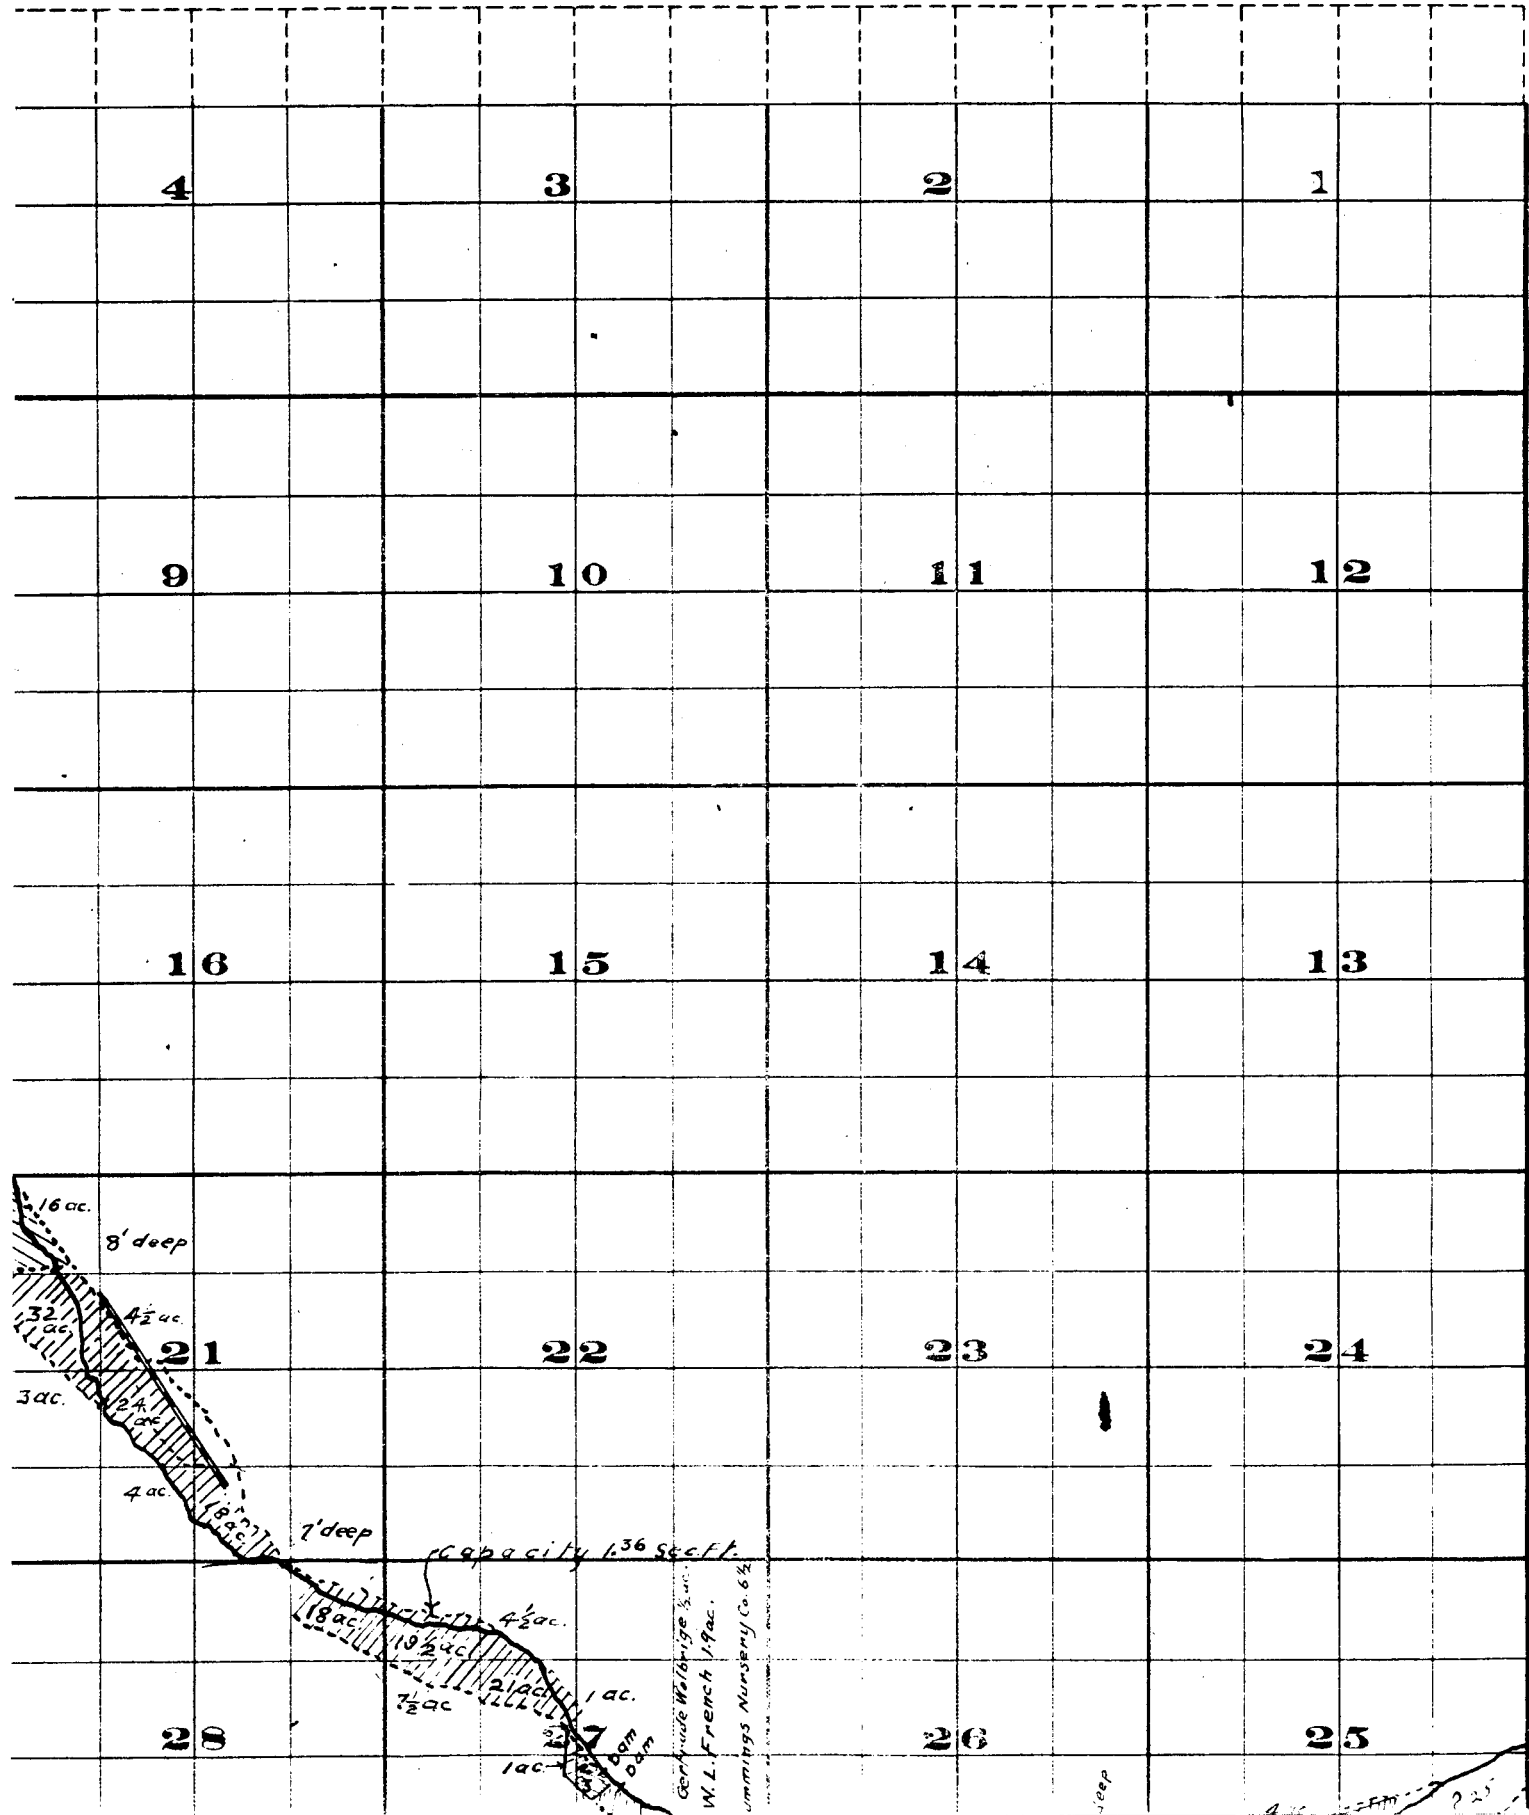

Township 2 S.

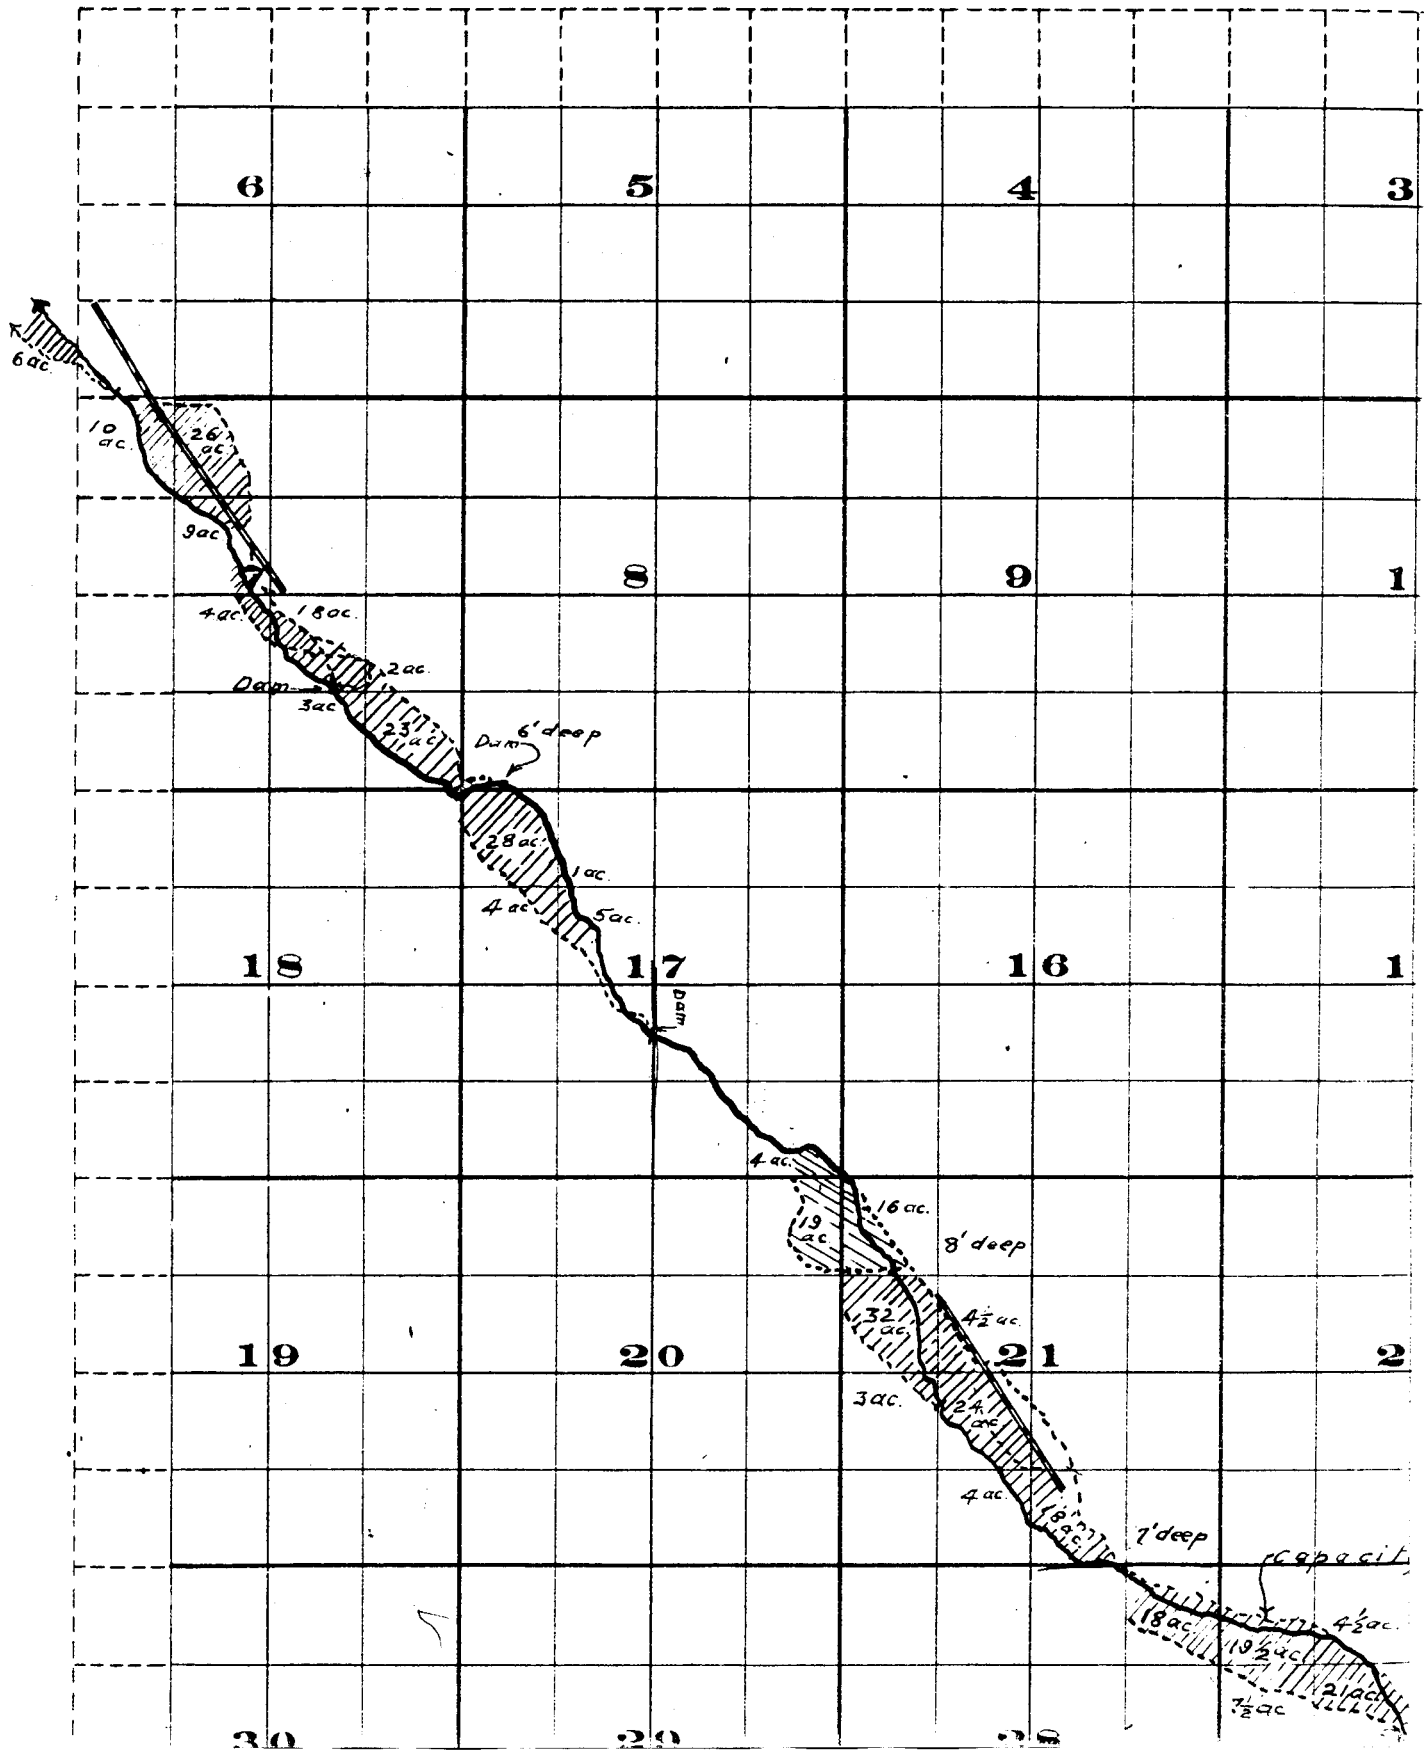

HEPPNER

Situated in T. 2S. R. 26E. W.M.

