


T. 7 S. R. 4 W. W.M.

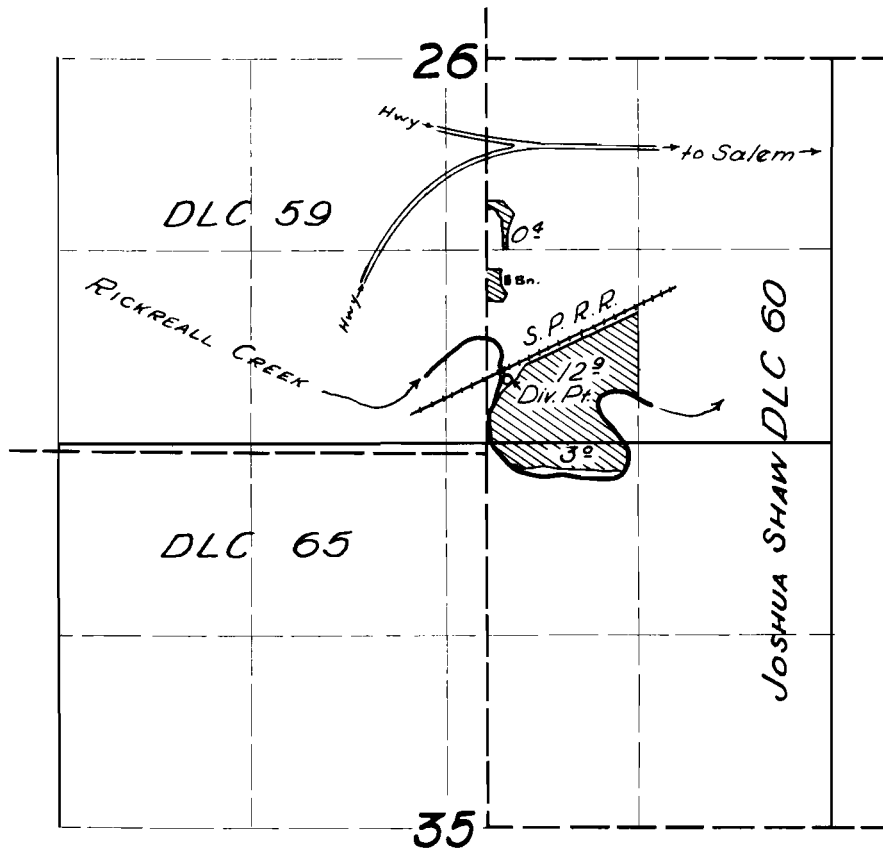

**FINAL PROOF SURVEY**  
UNDER

Application No. 25450 Permit No. 19906  
IN NAME OF

BURTON M. MEYERS

Surveyed 19 Mar. 1957, by R. A. Smith