


T.6S. R.6W.W.M.

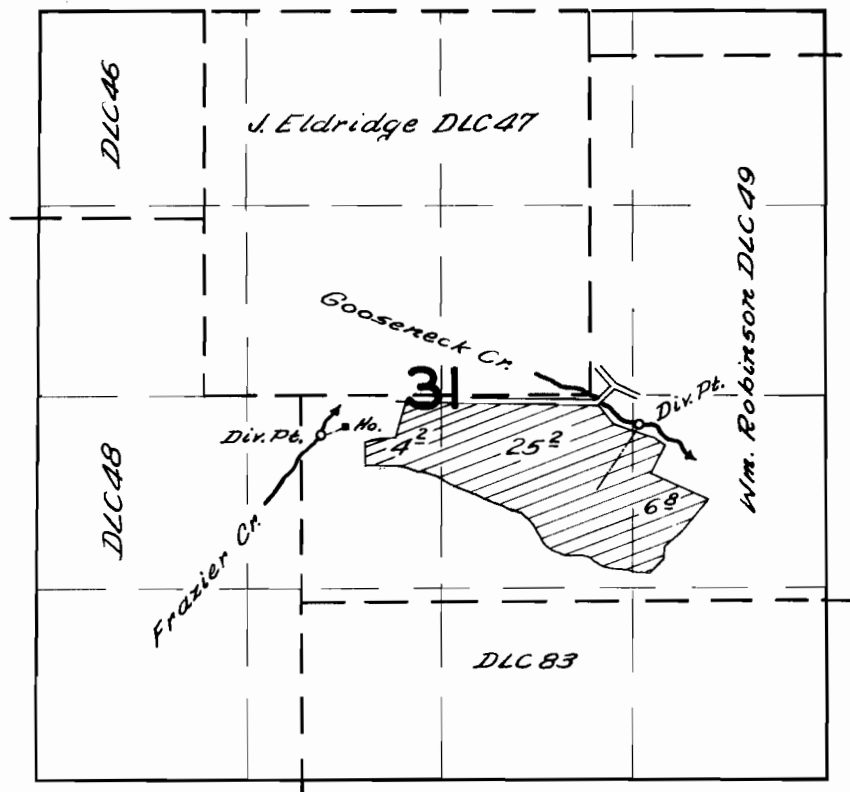

FINAL PROOF SURVEY  
UNDER

Application No. 24509 Permit No. 19921  
IN NAME OF

*L. Raymond Mishler*

Surveyed *Sept. 19* 1957, by *C.O. Burtch*