T.6 S. R. 1 W.W.M.

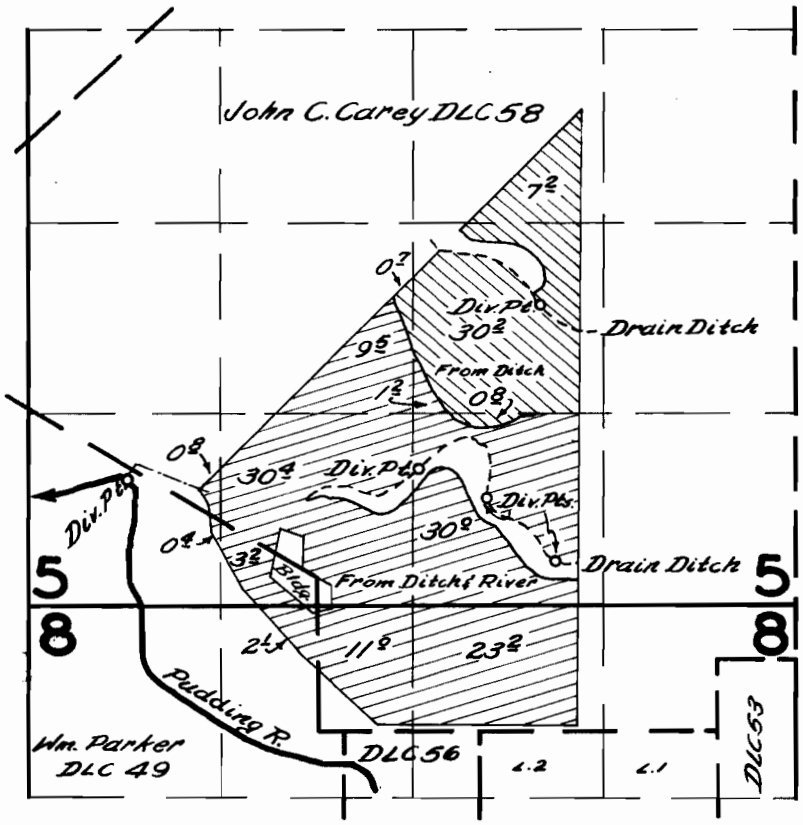

FINAL PROOF SURVEY
UNDER

Application No. 25765 Permit No. 20271
IN NAME OF

JOHN FITZSIMMONS

Surveyed Mar. 21 1957 by C.O. Bartels

DFN-2D-204