


T.28 S.R.4 W.W.M.

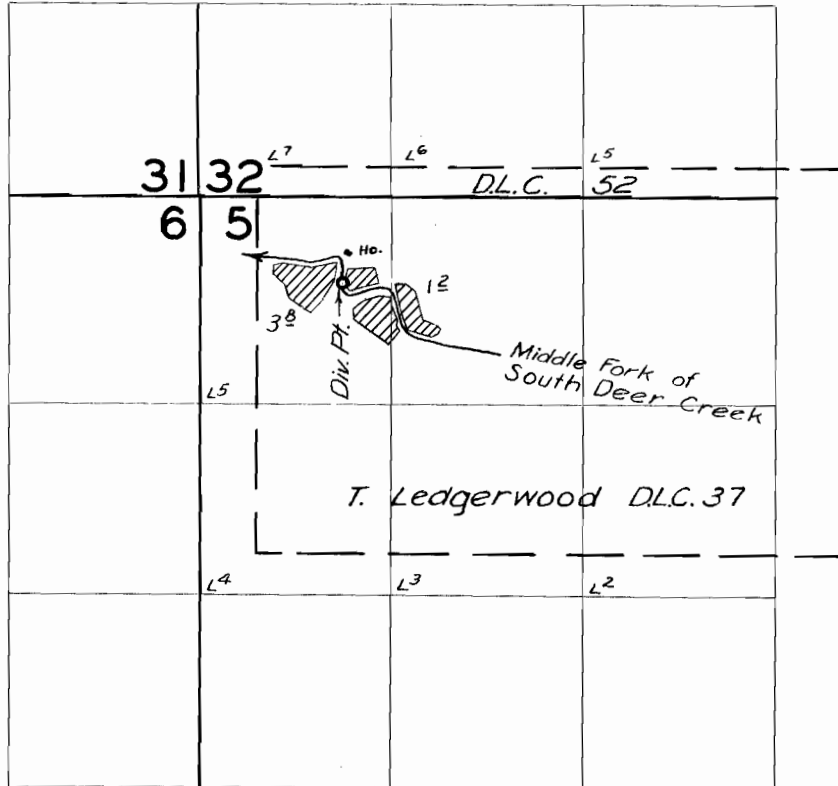

FINAL PROOF SURVEY

UNDER

Application No. 25920 Permit No. 20331

IN NAME OF

James Ingram

Surveyed July 16 1957, by m. Bech