


# T.23 S.R.5 W.W.M.

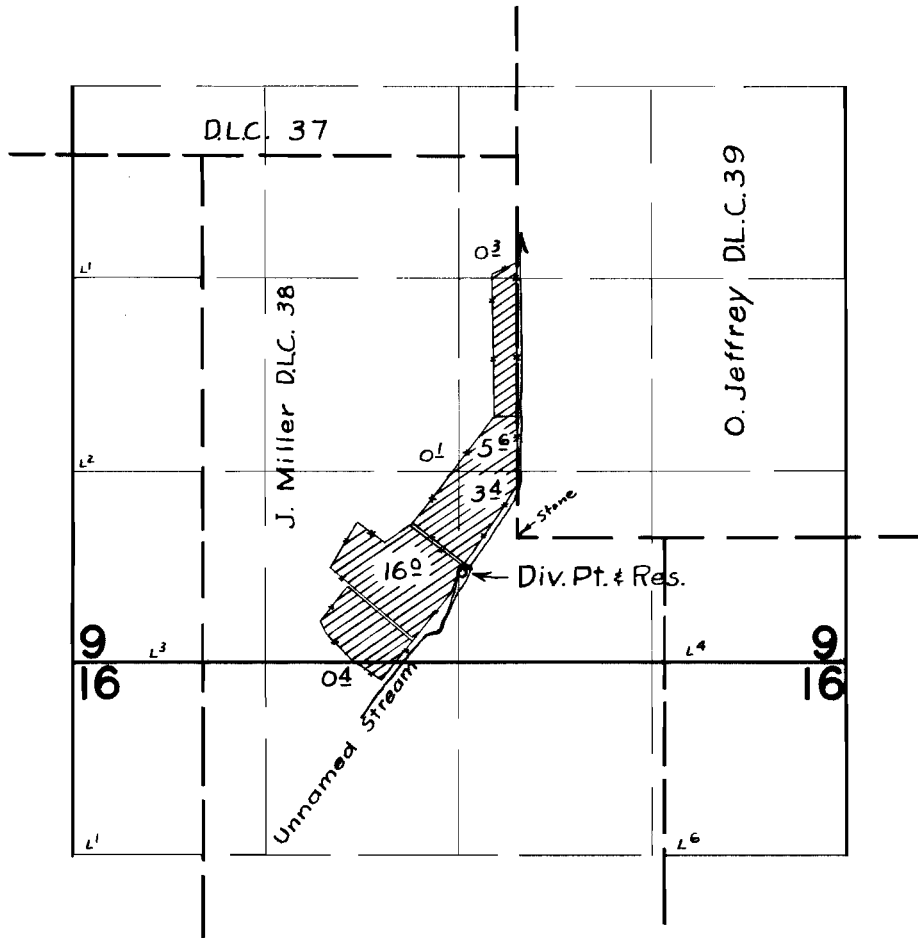

## FINAL PROOF SURVEY UNDER

Application No. 26183 Permit No. 20432  
IN NAME OF

Frances Huntington

Surveyed Sept. 11 1957, by m. Bish