


T.5S.R.1W.W.M.

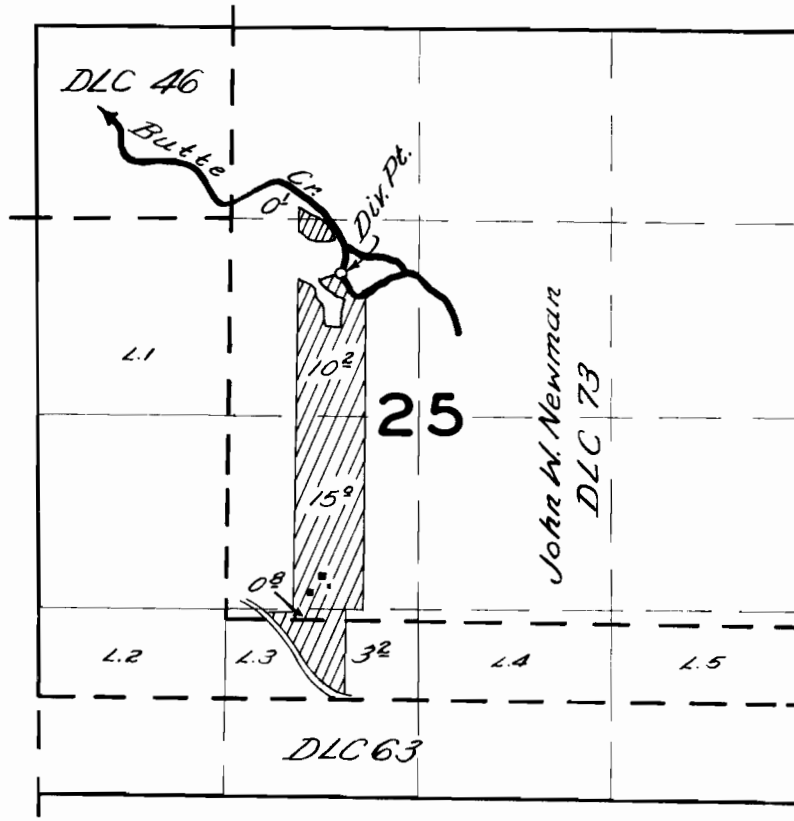

FINAL PROOF SURVEY UNDER

Application No. 25090 Permit No. 20496
IN NAME OF

Ralph Bochsler

Surveyed March 12 1957, by *C.D. Bartle*