


# T.17 S.R.3 W.W.M.

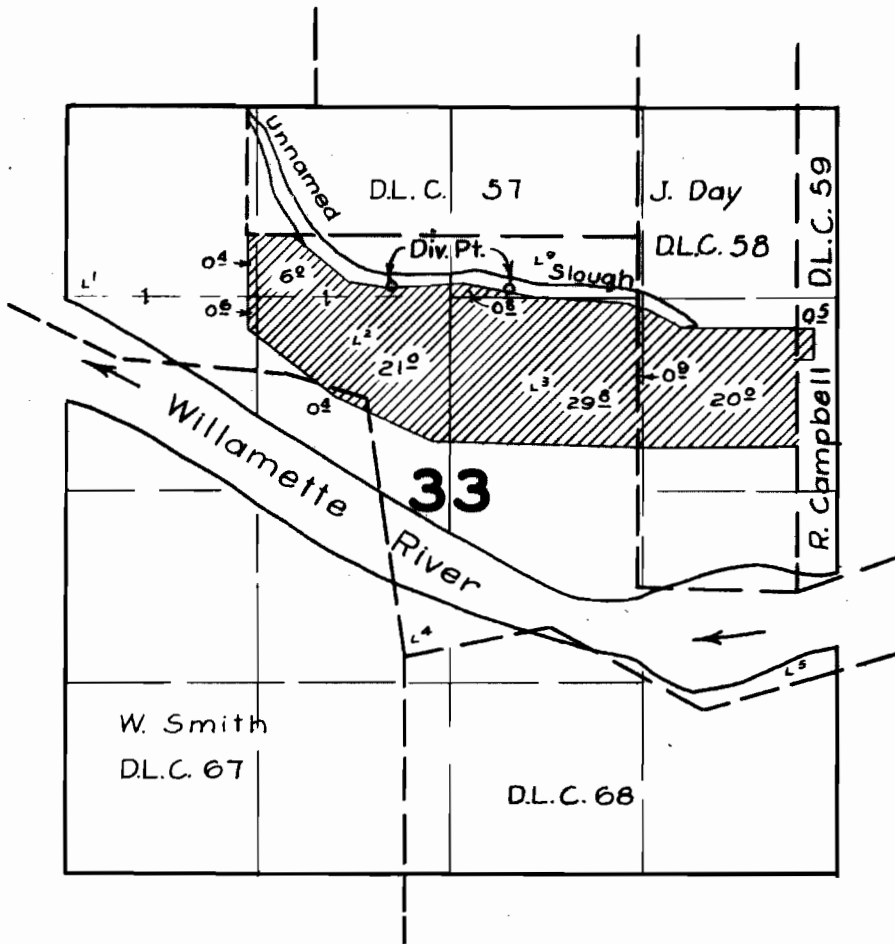

## FINAL PROOF SURVEY UNDER

Application No. 26292 Permit No. 20637  
IN NAME OF

J. R. M<sup>c</sup>Ky

Surveyed 30 April 1957, by m. Beck