


# T.14 S.R.6 W.W.M.

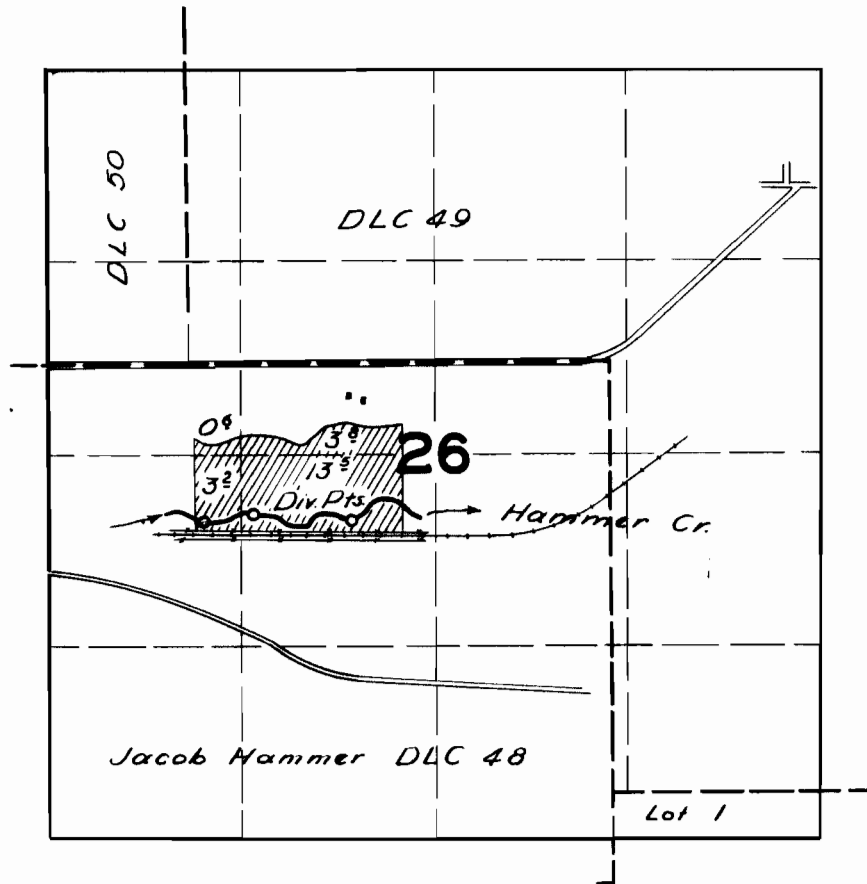

## FINAL PROOF SURVEY

UNDER

Application No. 26369 Permit No. 20693

IN NAME OF

W. T. McCLAGHRY

Surveyed 22 Apr 1957, by *[Signature]*