


T.I.S.R.I.E.W.M.

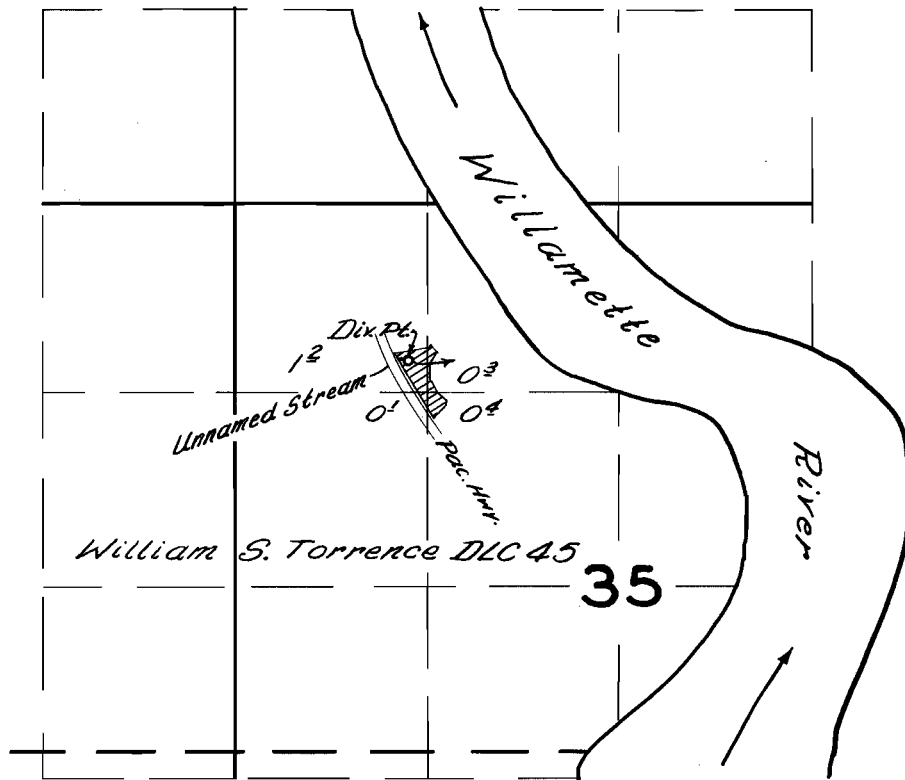

**FINAL PROOF SURVEY**  
UNDER

Application No. *26517* Permit No. *20784*  
IN NAME OF

*DONALD W. BREE*

Surveyed *Aug. 21* 1957, by *C.O. Smith*