


T. 18S. R. 11W. W.M.

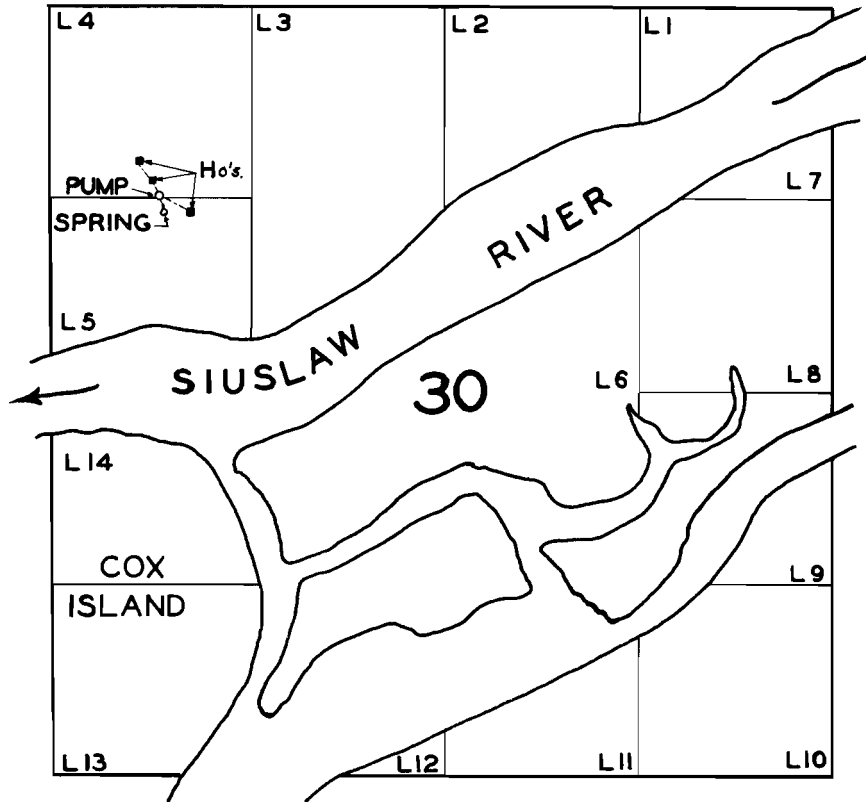

**FINAL PROOF SURVEY**  
UNDER

Application No. 26512. Permit No. 21005  
IN NAME OF

**LAWRENCE W. & ELIZABETH DERRIN**

Surveyed MAY 22 1957, by *Edwin Hilby*