


T.16S.R.5W.W.M.

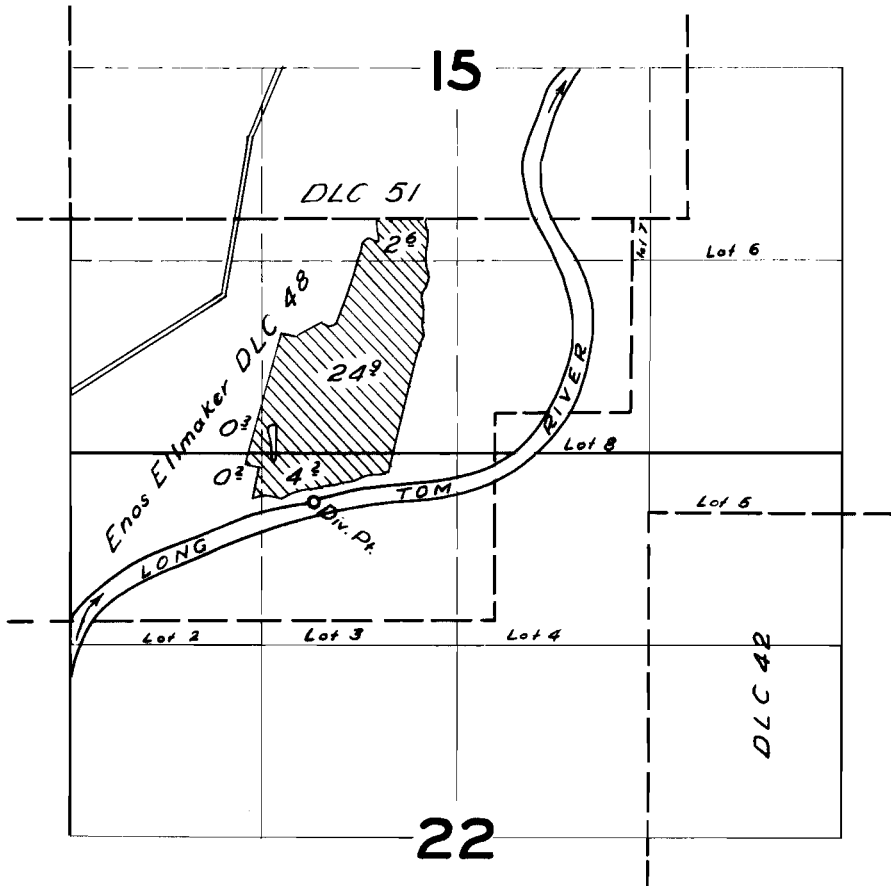

FINAL PROOF SURVEY

UNDER

Application No. 26844 Permit No. 21082

IN NAME OF

SILAS B. MOFFITT

Surveyed 9 April 1957, by [Signature]