


T.16S.R.5W.W.M.

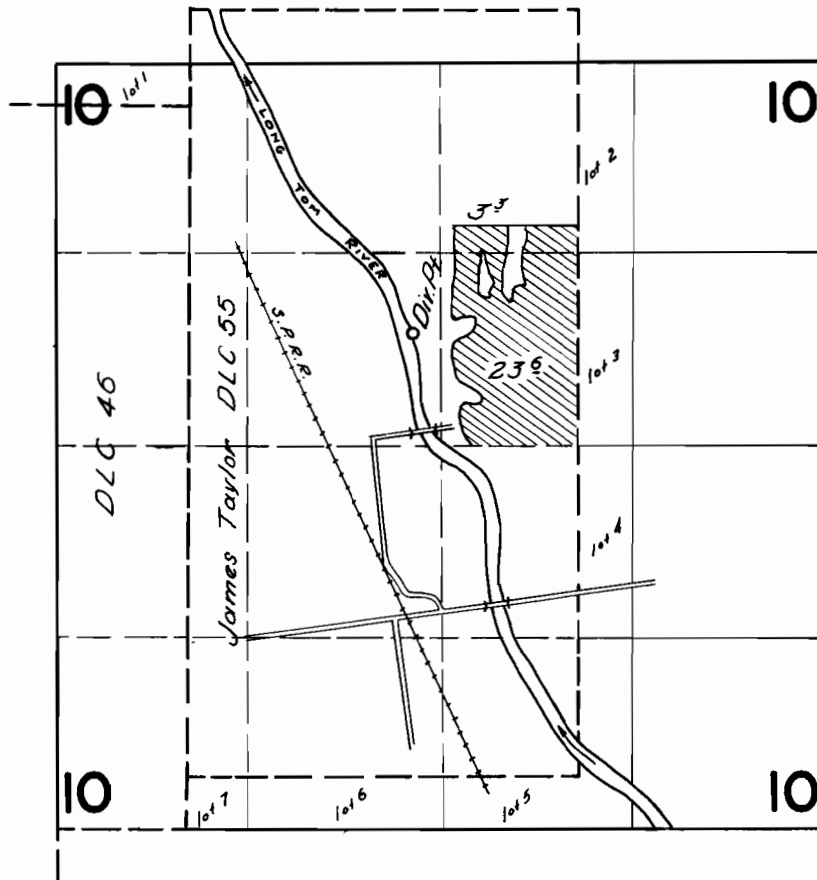

FINAL PROOF SURVEY
UNDER

Application No. 26912 Permit No. 21147

IN NAME OF

C. L. CHESHIRE

Surveyed 9 April 1957, by *[Signature]*