


# T.29 S.R.8 W.W.M.

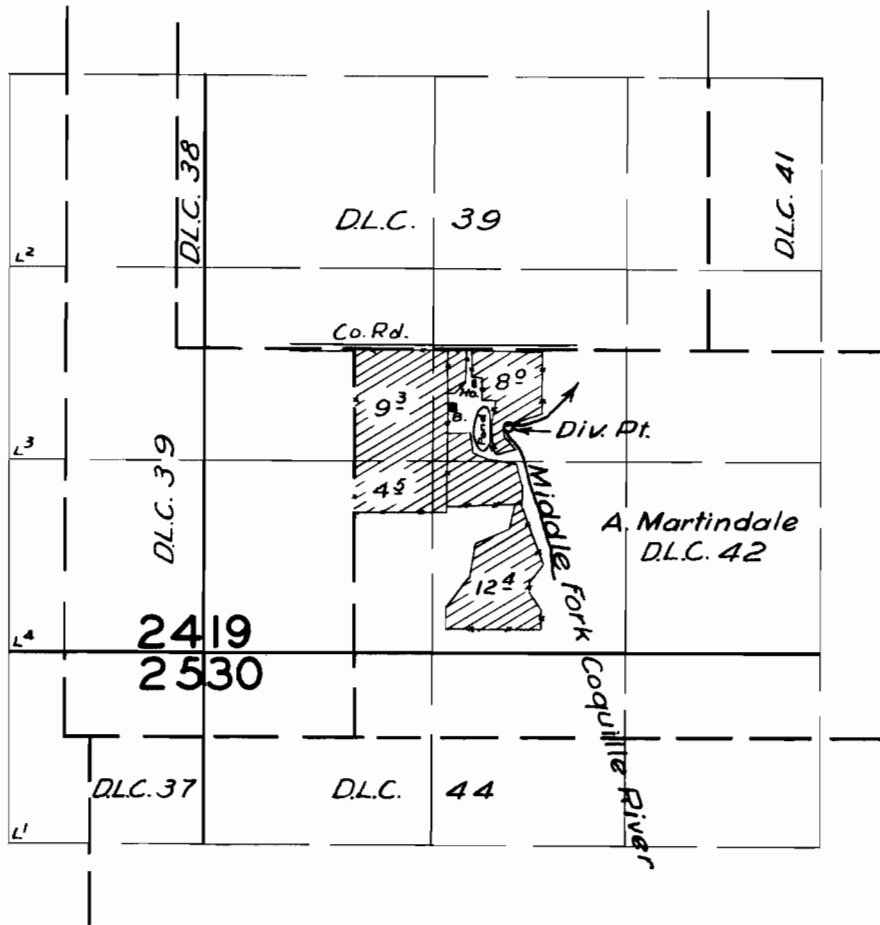

## FINAL PROOF SURVEY UNDER

Application No. 26989 Permit No. 21198  
IN NAME OF

A.A. Schafer

Surveyed JULY 20 1957, by Tom Bieh