


T.18 S.R.3 W.W.M.

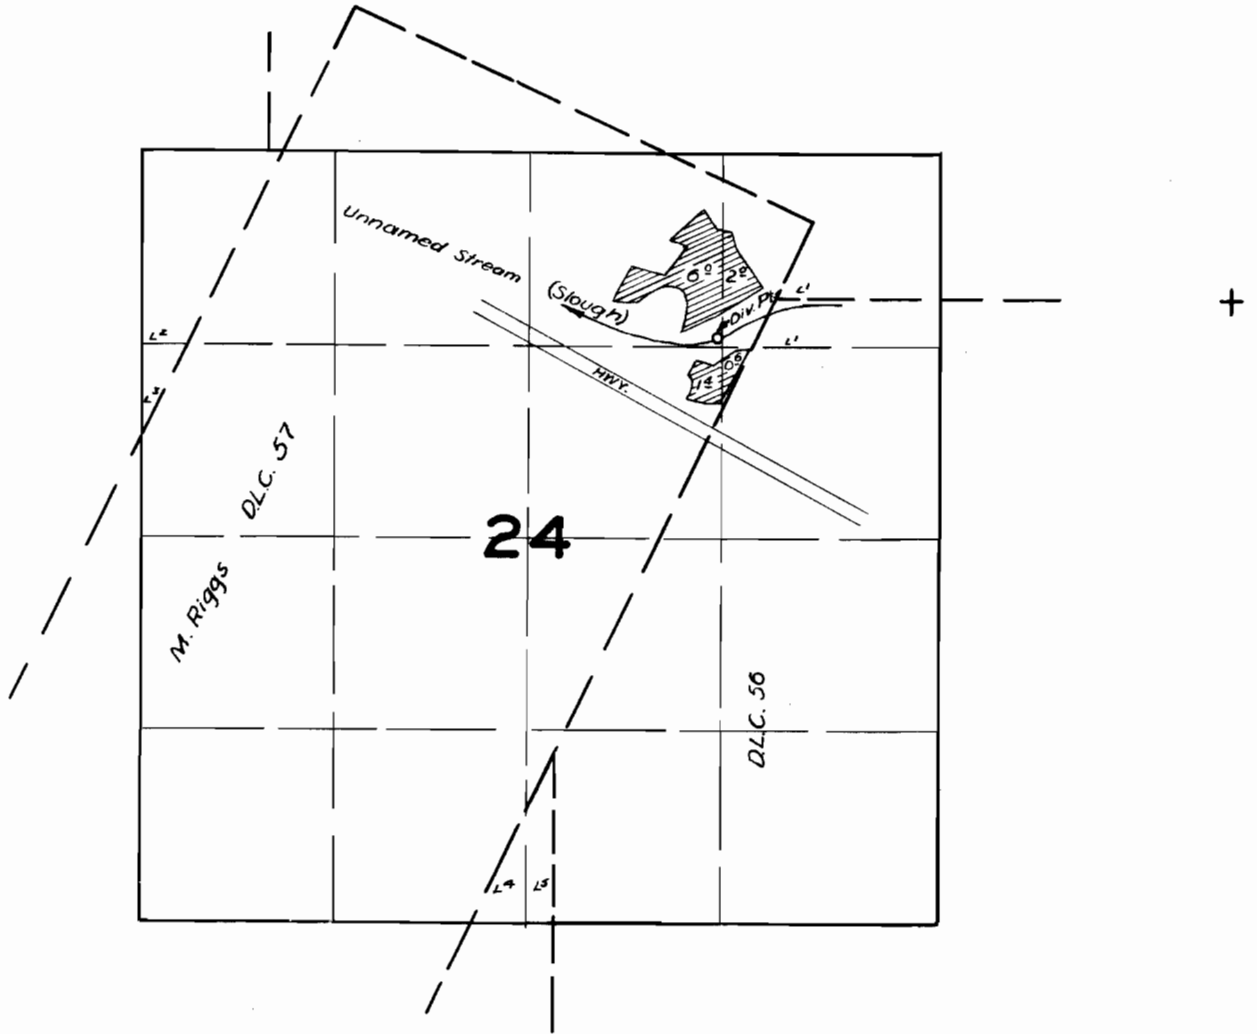

FINAL PROOF SURVEY

UNDER

Application No. 25940 Permit No. 21242...

IN NAME OF

Jennie M. & Oscar Milligan

Surveyed *May 2* 1957, by *Tr. Bish*