


T.5-6S.R.1W.W.M.

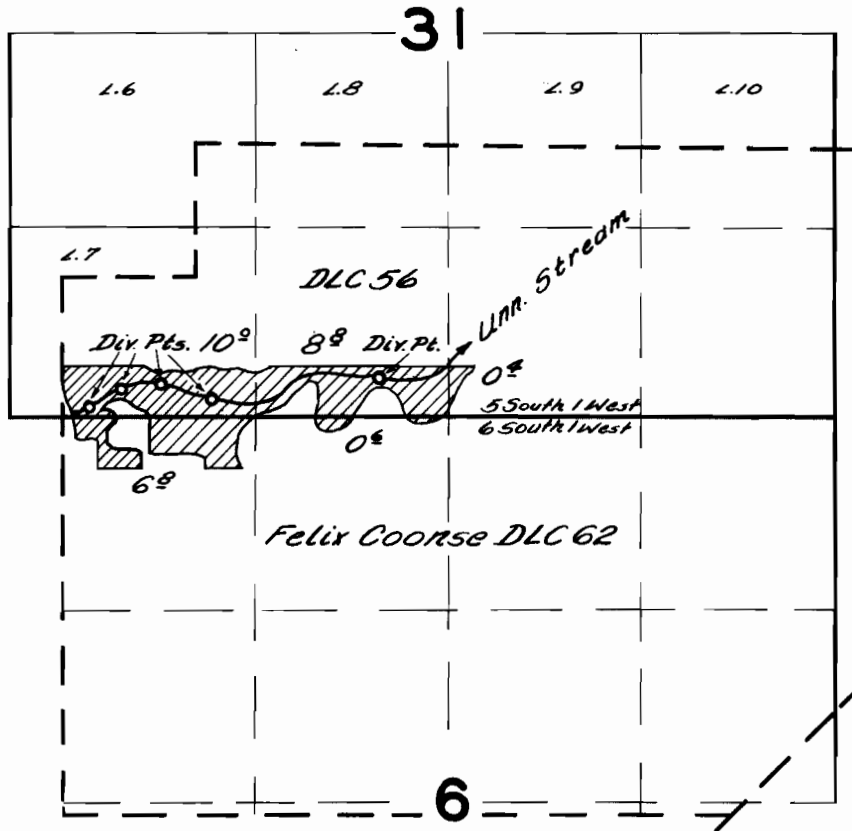

FINAL PROOF SURVEY UNDER

Application No. 26207. Permit No. 21252
IN NAME OF

John Kuschnick

Surveyed *March 11 1957*, by *C.O. Bartels*