


T.14S.R.5&6W.W.M.

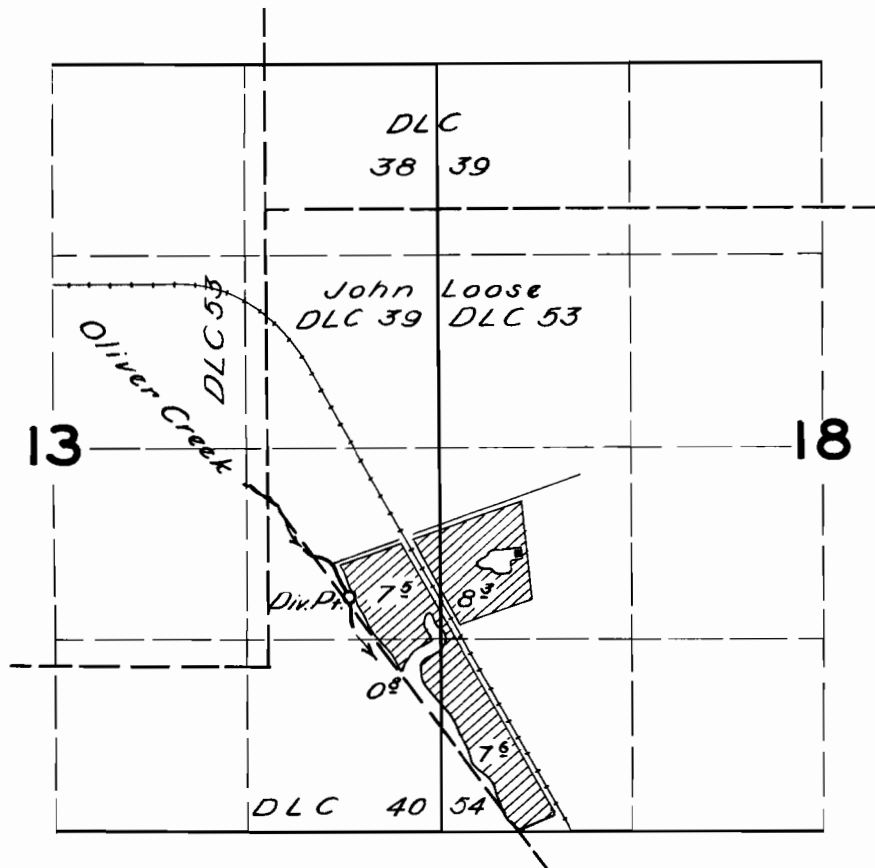

FINAL PROOF SURVEY UNDER

Application No. 27033 Permit No. 21274
IN NAME OF

CLIFFORD A. LARKIN

Surveyed 23 Apr. 1957, by *A. Whitley*