


T.23 S.R.6 W.W.M.

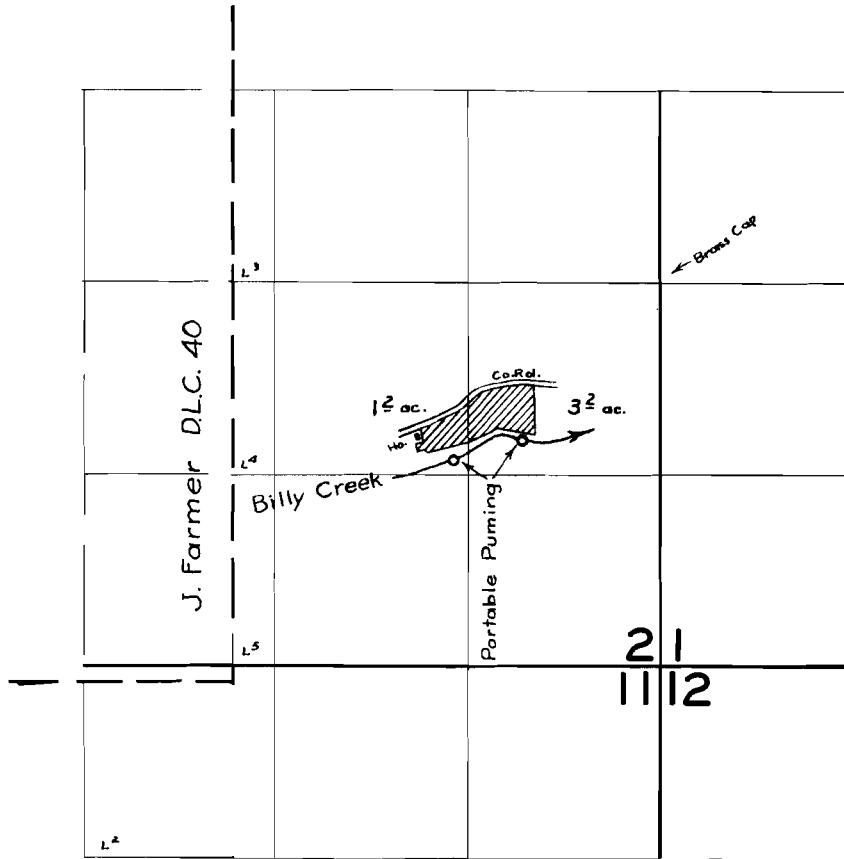

FINAL PROOF SURVEY UNDER

Application No. 27331 Permit No. 21488
IN NAME OF

Byron DeVore

Surveyed Sept. 10 1957, by T. B. Bish