


T.26S.R.6W.W.M.

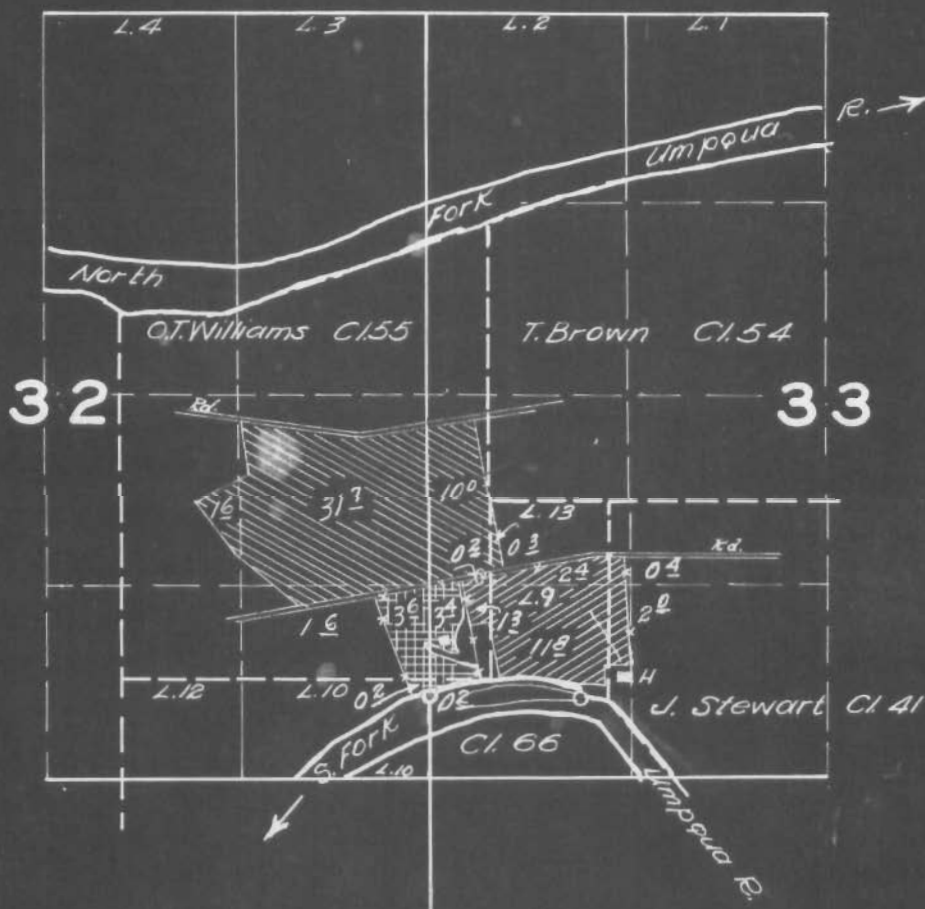

FINAL PROOF SURVEY

UNDER

26333

20663

Application No. 27183 Permit No. 21379

IN NAME OF

W. H. Carter

M. B. Emmitt & H. B. Kruse

Surveyed July 21, 1954, by H. L. Coffman

27183 Kruse

27183 Emmitt

26333 Carter



Db-Hw-17-20
Pantograph