


T.20S.R.3 W.W.M.

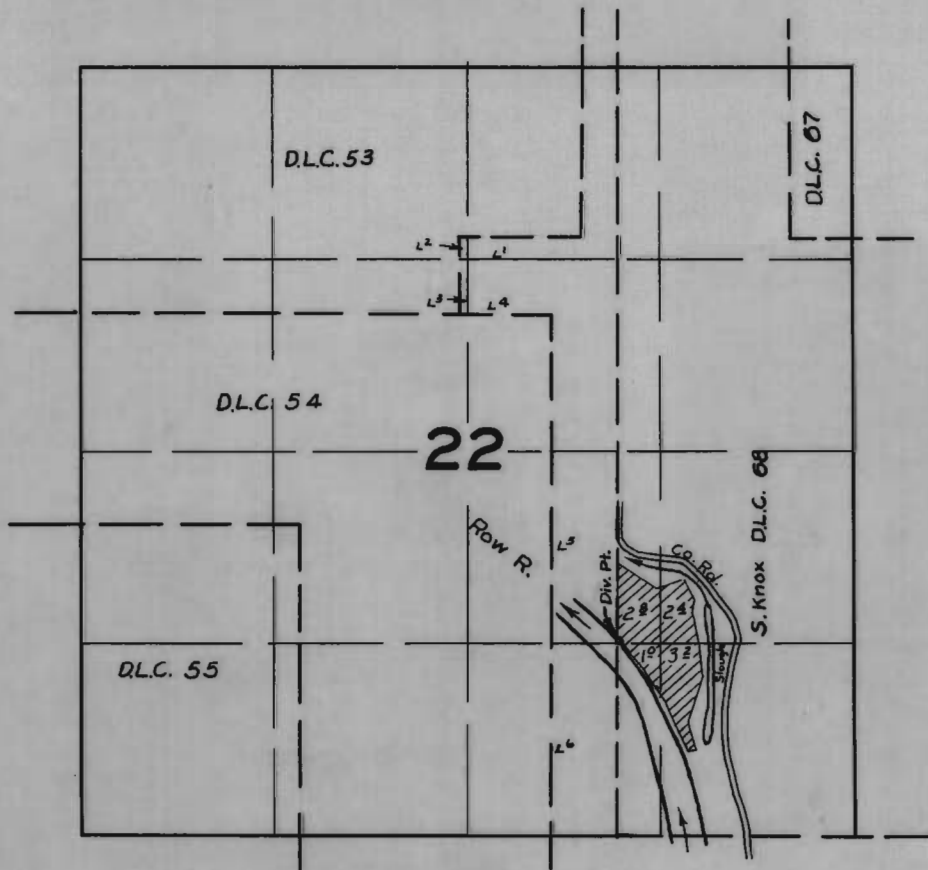

FINAL PROOF SURVEY
UNDER

Application No. 27454 Permit No. 21614
IN NAME OF

George Molitor

Surveyed April 18, 1957, by *M. Bish*