


T. 6S. R. 1E. W.M.

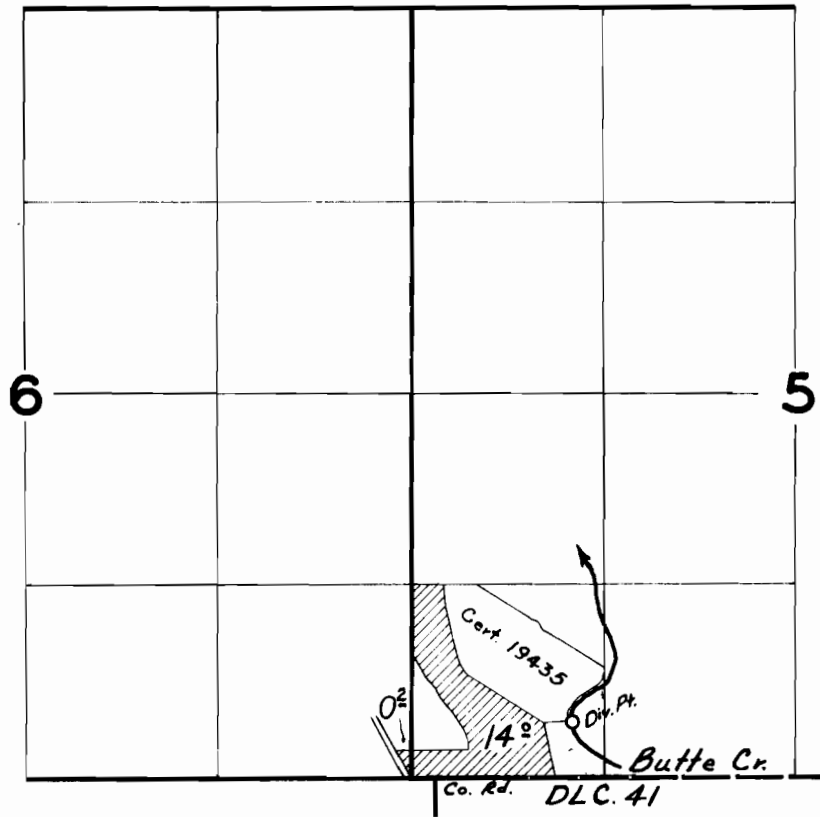

FINAL PROOF SURVEY

UNDER

Application No. **27459** Permit No. **21616**

IN NAME OF

EARL ROSS

Surveyed **MAR. 21, 1957**, by *C. O. Bostels*