


# T.14S.R.5W.W.M.

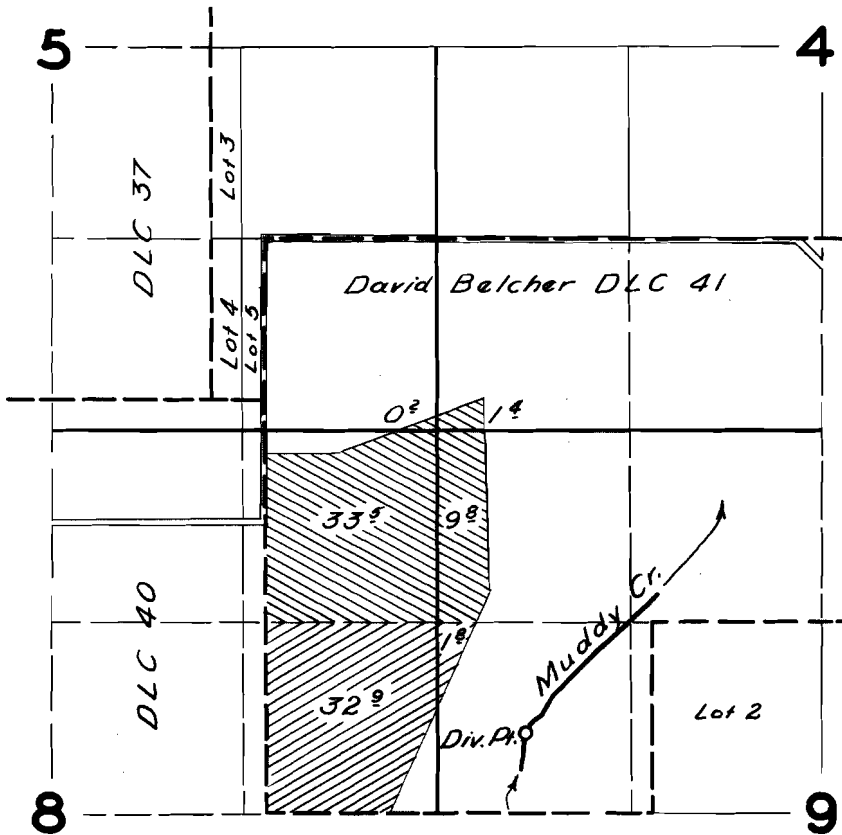

## FINAL PROOF SURVEY

UNDER

27610

21749

Application No. 26984

Permit No. 21195



IN NAME OF

*C. B. READER*

Surveyed 24 Apr. 1957, by *[Signature]*