


T.10 S.R.2 W.W.M.

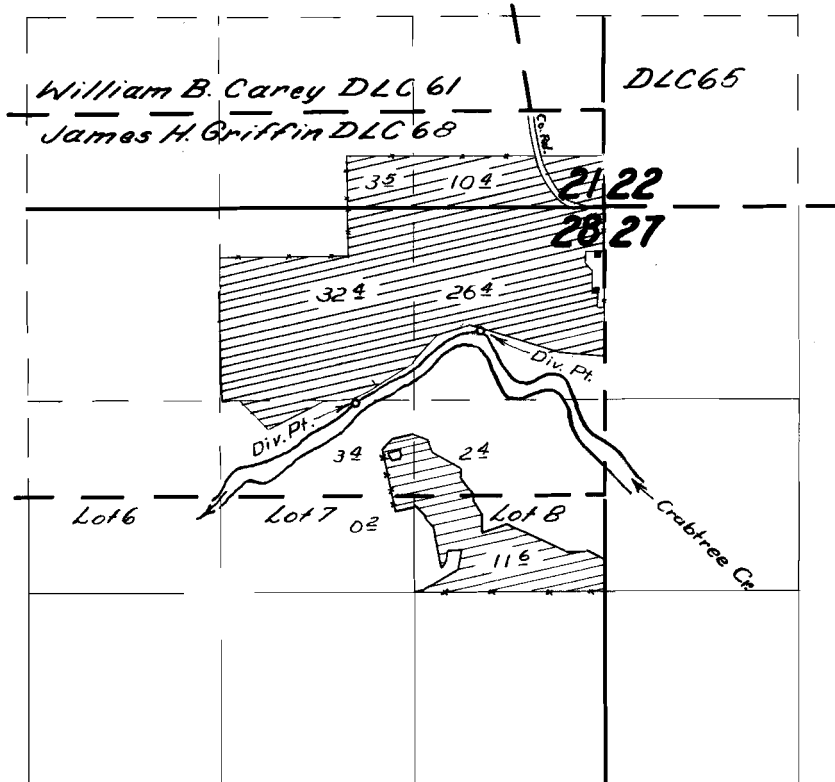

FINAL PROOF SURVEY
UNDER

Application No. 27656 Permit No. 21781
IN NAME OF

Fred W. & Anna V. Mespelt

Surveyed Mar. 15 May 3 1957, by M. B. Bush
C. O. Smith