


T.22S.R3W.W.M.

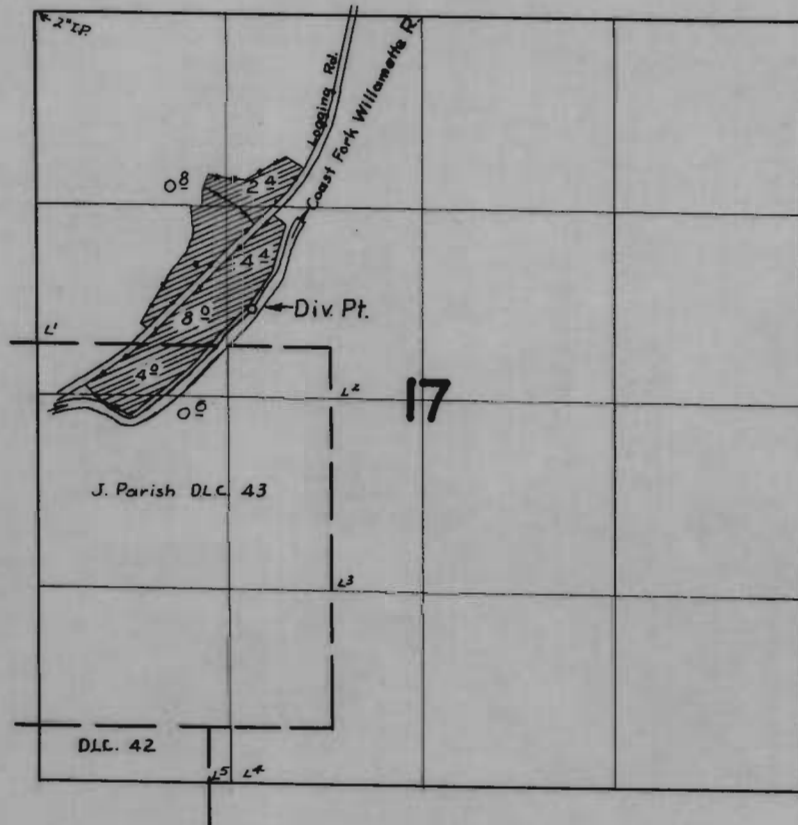

FINAL PROOF SURVEY  
UNDER

Application No. 27305 Permit No. 21935  
IN NAME OF

Edward T. Rothauge

Surveyed April 23, 1957, by M. Bish