


T.4S.R.2W.W.M.

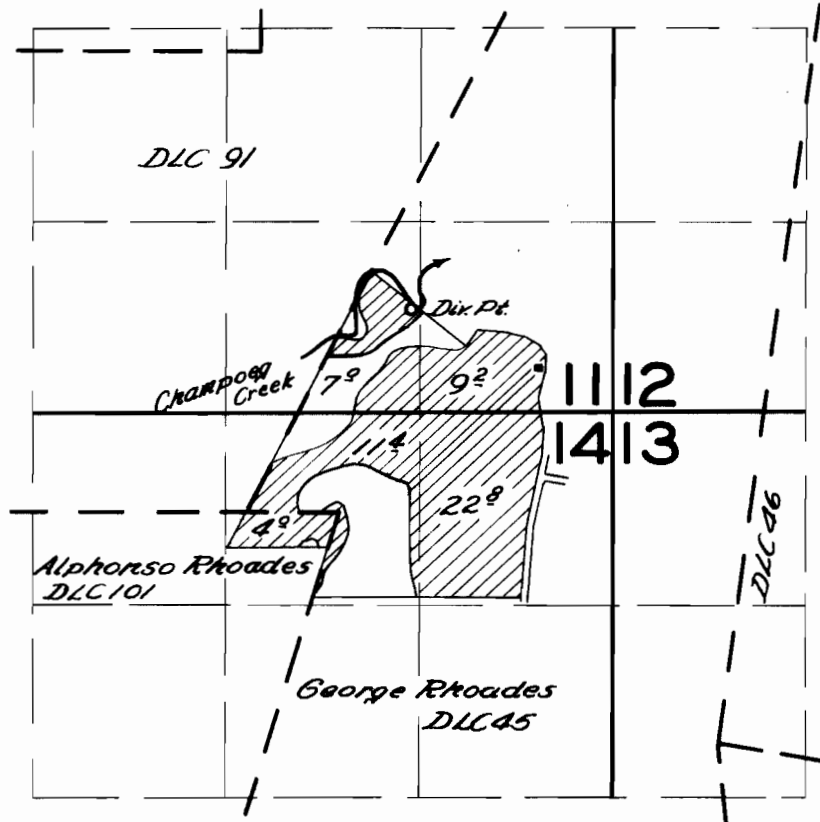

**FINAL PROOF SURVEY**  
UNDER

Application No. 27893 Permit No. 21971  
IN NAME OF

JOHN D. WINSLOW

Surveyed March 13 1957, by C.D. Smith