


T.20 S. R. 3 W. W. M.

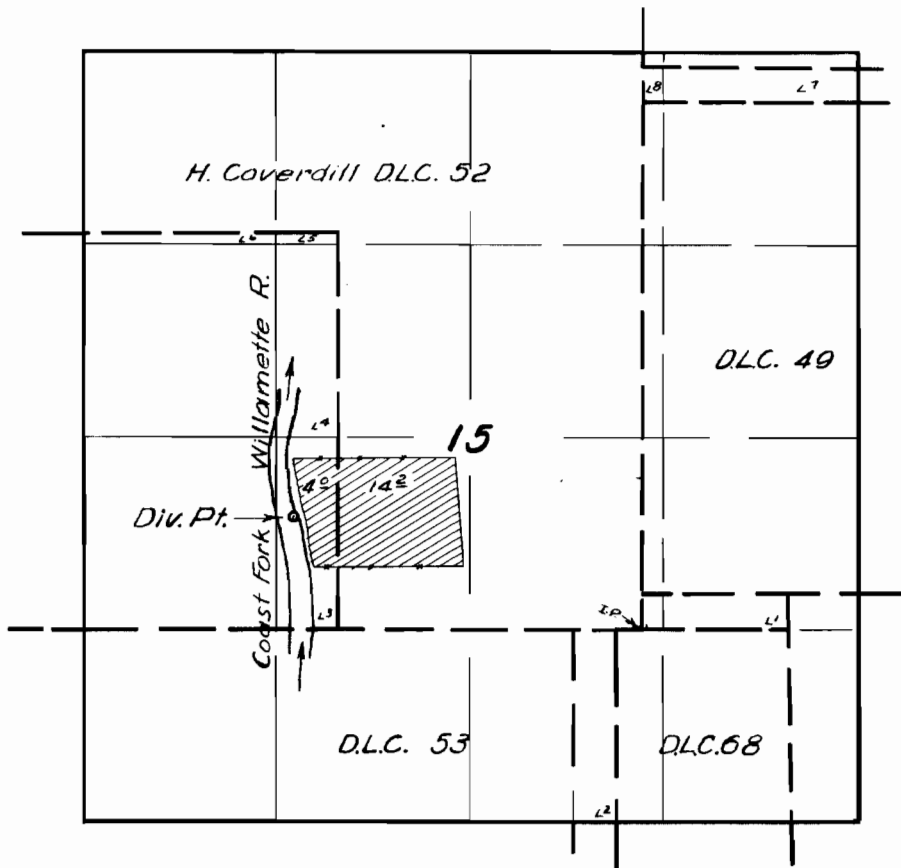

FINAL PROOF SURVEY

UNDER

Application No. 28055. Permit No. 22068.

IN NAME OF

G. R. Sears

Surveyed April 12 1957, by *T. M. Bish*