


T29S. R. 5W. W.M.

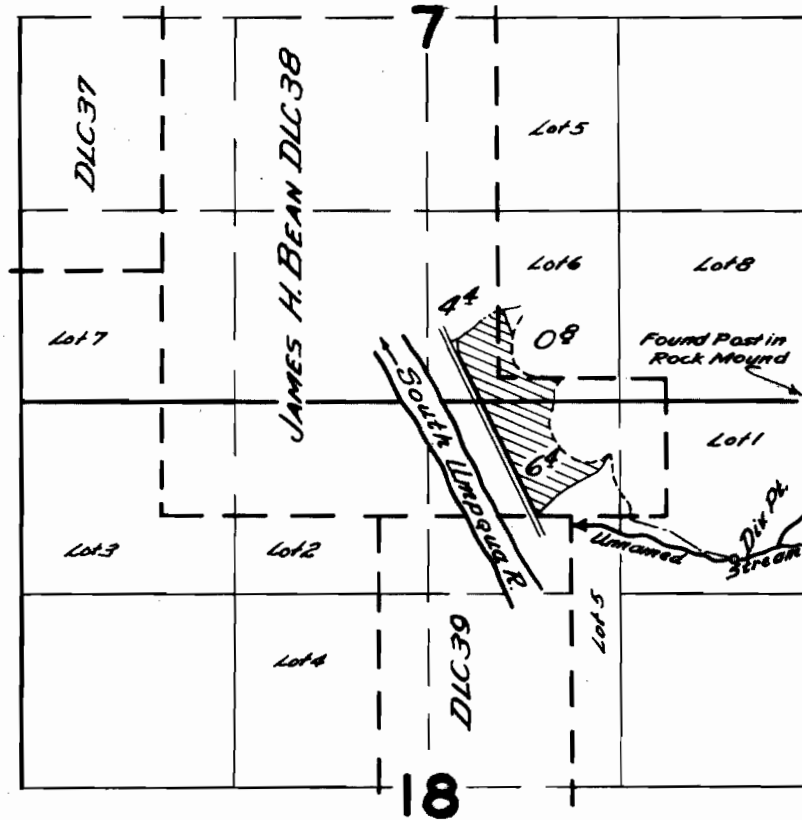

FINAL PROOF SURVEY
UNDER

Application No. 28022 Permit No. 22116
IN NAME OF

W. A. BLACKERT

Surveyed April 14, 1957, by C. O. Burtch