


T.5S.R.1W.W.M.

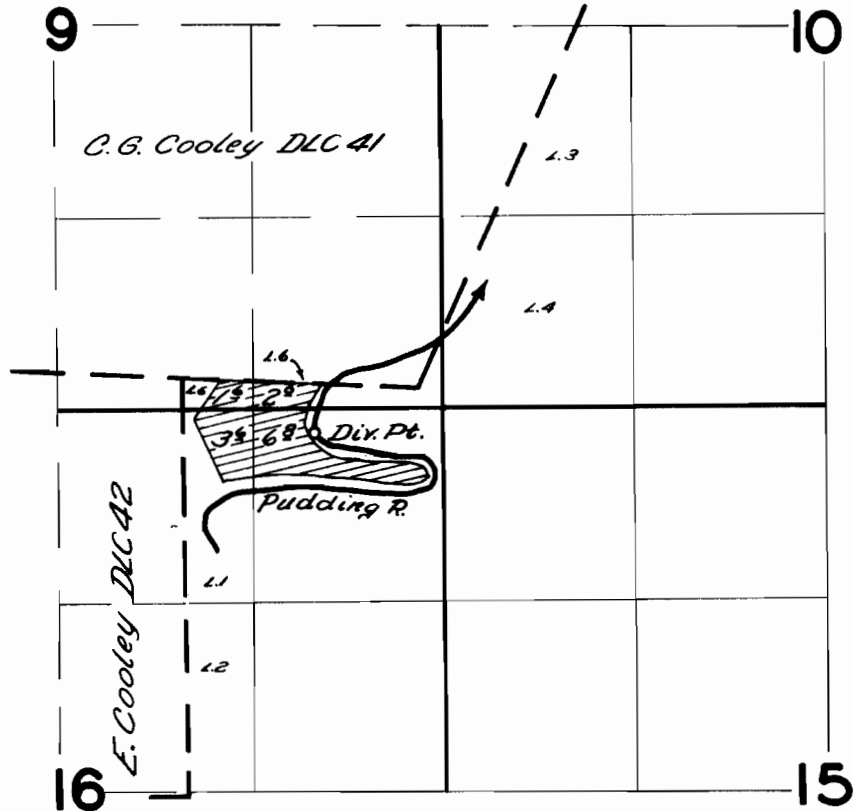

FINAL PROOF SURVEY
UNDER

Application No. 28146... Permit No. 22152...
IN NAME OF

Fred P. Schindler

Surveyed *March 12 1957*, by *C.O. Banteb*