


T.20 S. R. 2 W. W. M.

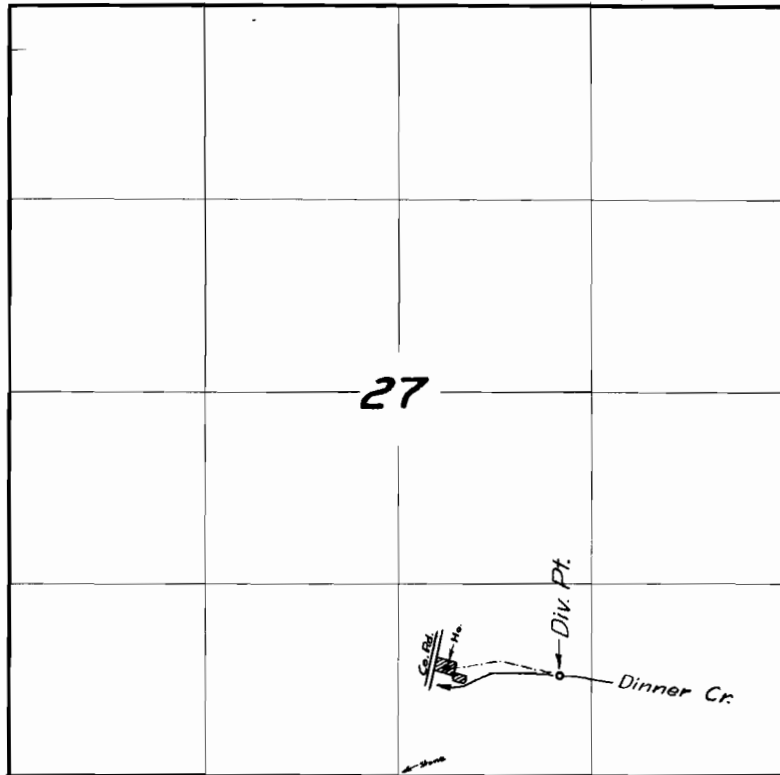

FINAL PROOF SURVEY
UNDER

Application No. 28225 Permit No. 22205
IN NAME OF

Arthur or Helen B. Bales

Surveyed April 11, 1957, by M. B. Bales