


# T.27S.R.7 W.W.M.

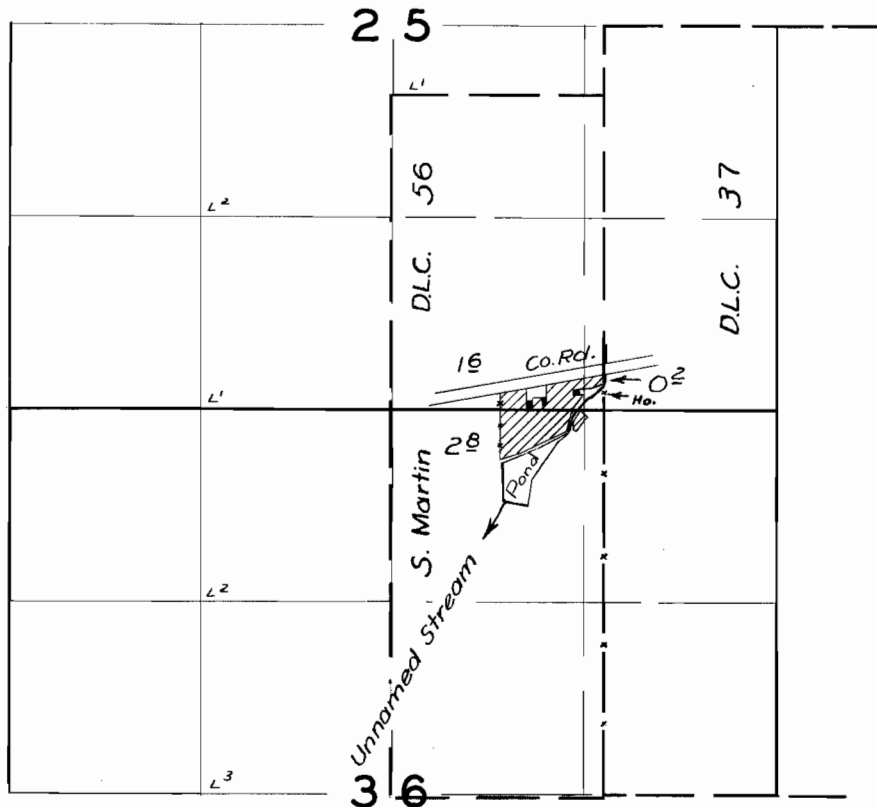

## FINAL PROOF SURVEY UNDER

Application No. 28301 Permit No. 22251  
IN NAME OF

Thomas H. Hubbard

Surveyed July 16, 1957, by M. Bish