


T. 28 & 29S. R. 6W W.M.

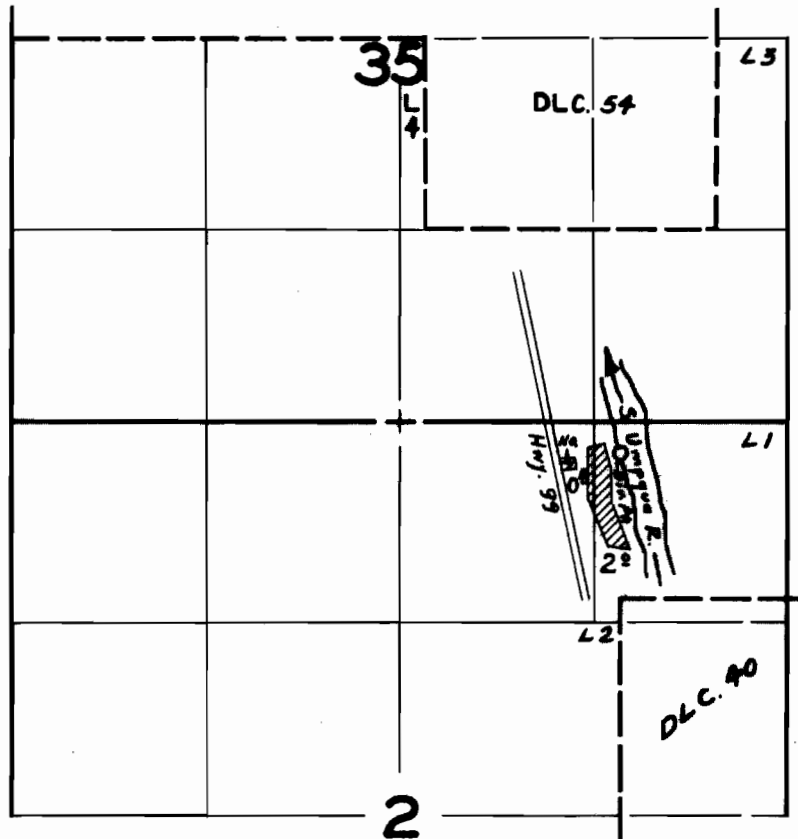

FINAL PROOF SURVEY
UNDER

Application No. 28490 Permit No. 22310
IN NAME OF

C.W. & LILLIAN PERRY

Surveyed Apr. 9 1957, by C.O. Bartels