


T.29S.R.6W.W.M.

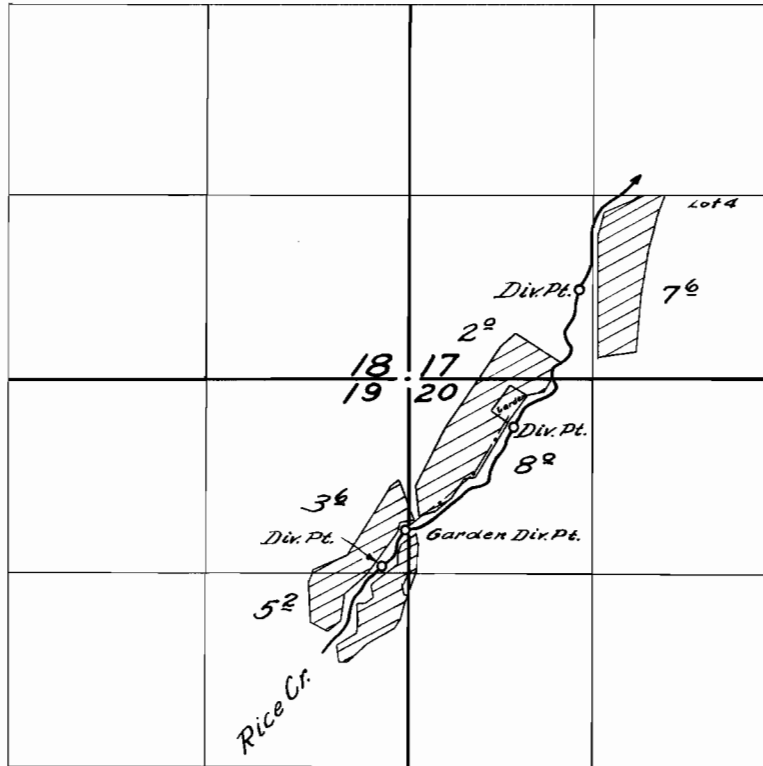

FINAL PROOF SURVEY
UNDER

Application No. 28372 Permit No. 22385
IN NAME OF

..... *OLLIE I. BOYD*

Surveyed *April 10* 1957, by *C. O. Burt*