


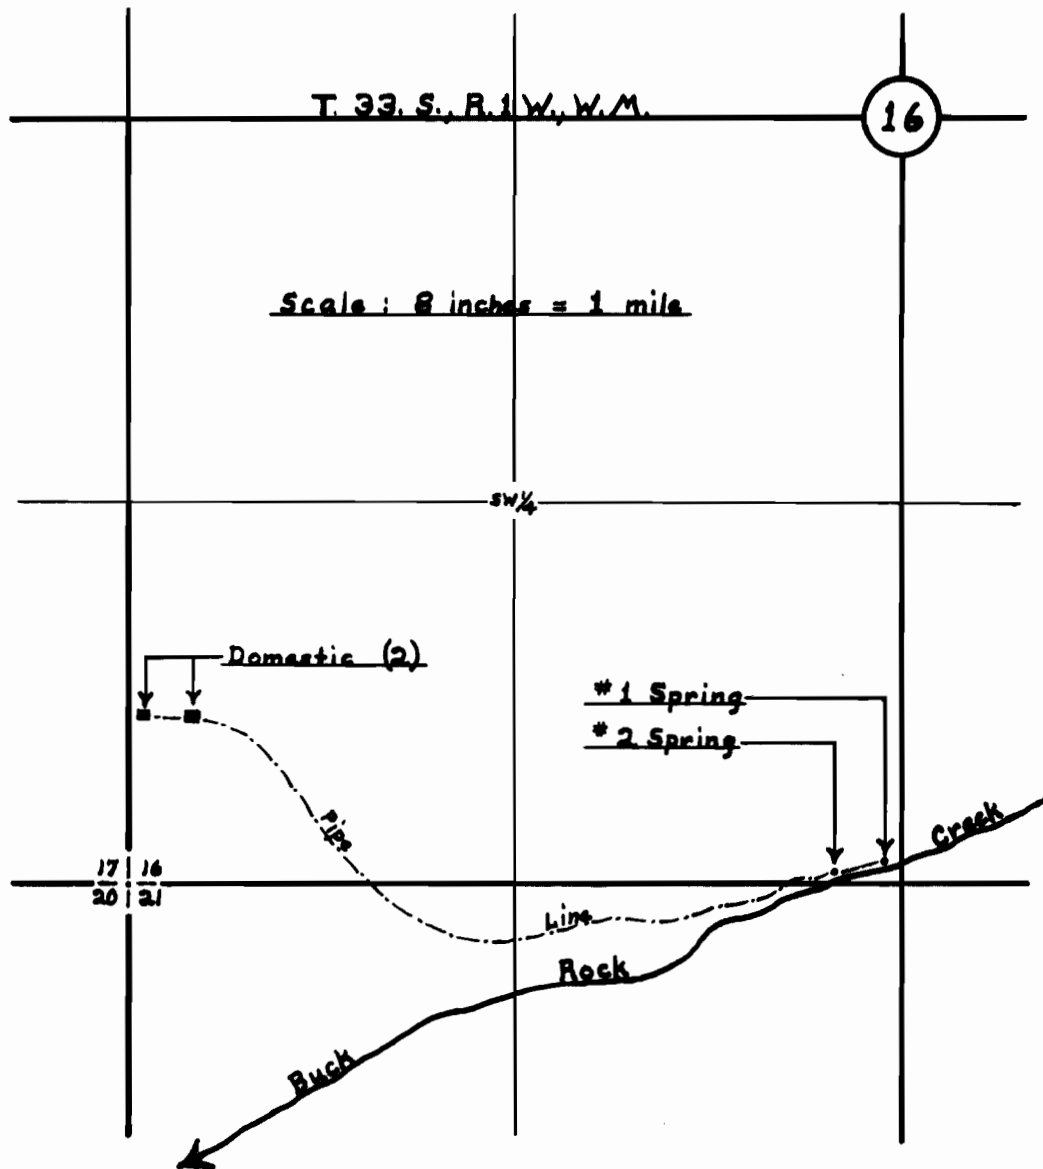


FINAL PROOF SURVEY UNDER

Application No. 28640 Permit No. 22550
IN NAME OF

Mildred E. Barnhart

Surveyed March 19 1958, by D.C. Hendrix, W.M.

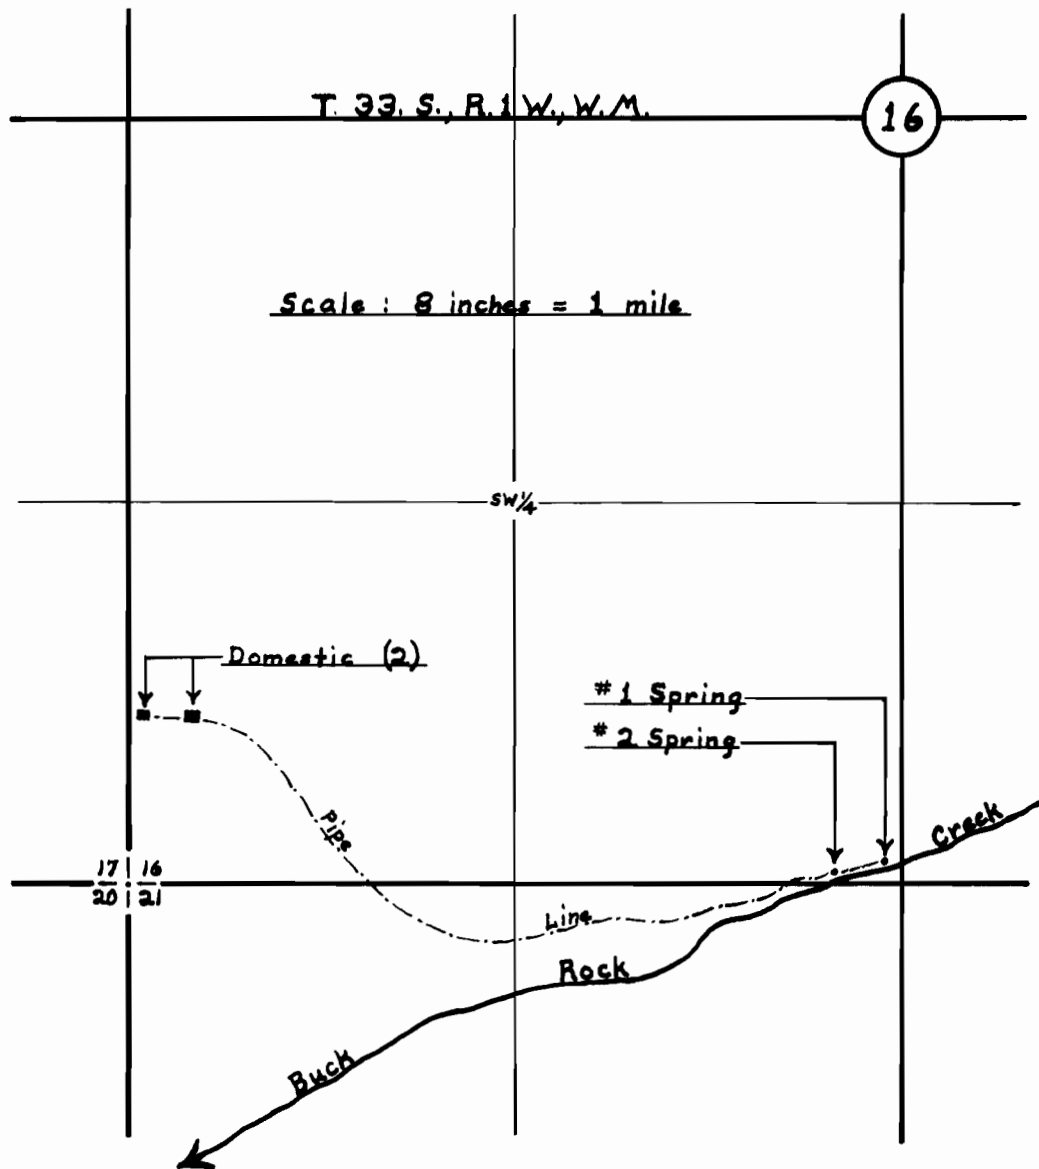

FINAL PROOF SURVEY UNDER

Application No. 28640 Permit No. 22550
IN NAME OF

Mildred E. Barnhart

Surveyed March 19 1958, by D.C. Hendrix, W.M.