


T.16S.R.6W.W.M.

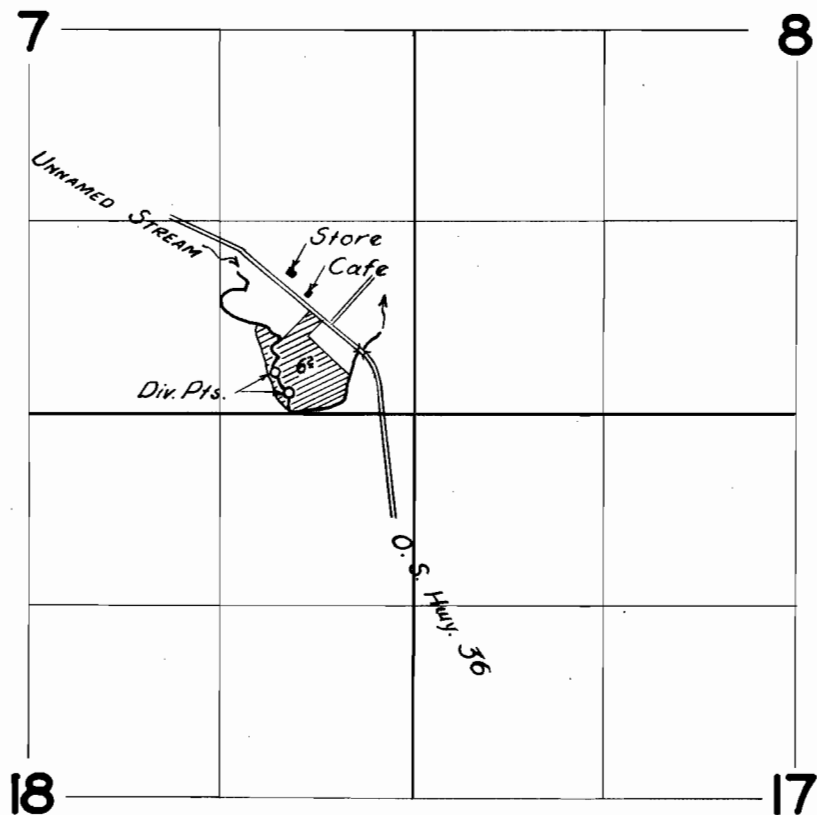

FINAL PROOF SURVEY
UNDER

Application No. 29194 Permit No. 22947
IN NAME OF

ORVILLE GILLESPIE & J. W. FIGG

Surveyed 11 April 1957, by [Signature]