


# T.29S.R.6W.W.M.

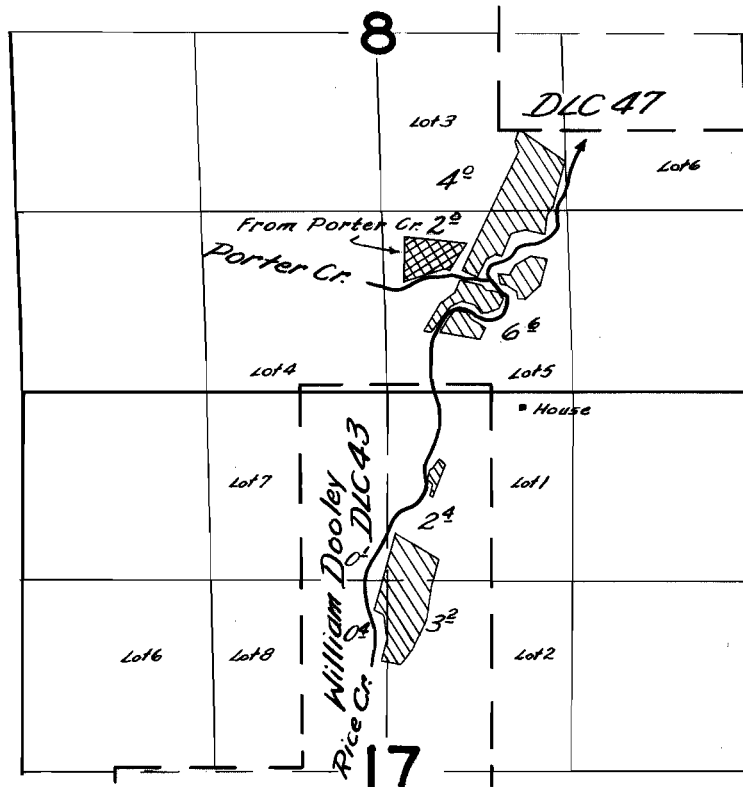

## FINAL PROOF SURVEY UNDER

Application No. 29140... Permit No. 23062.  
IN NAME OF

HARRISON RICE

Surveyed April 10 1957, by Ed. Smith