


T.27S.R.3W.W.M.

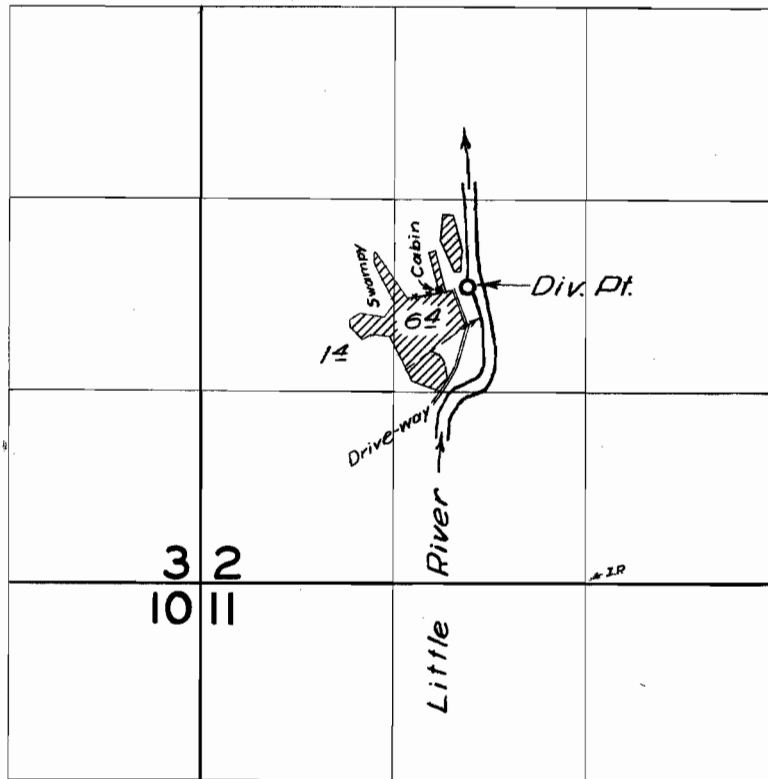

FINAL PROOF SURVEY

UNDER

Application No. 29169 Permit No. 23067

IN NAME OF

Ernest F. Roglitz

Surveyed July 17, 1957, by M. Bish