


T. 19S. R. 5W. W.M.

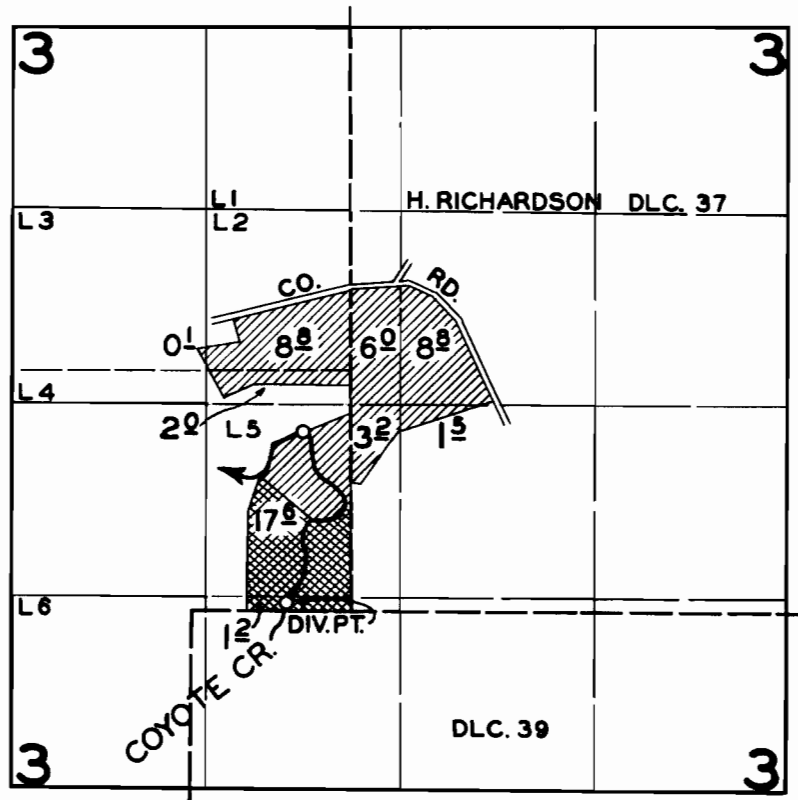

FINAL PROOF SURVEY
UNDER

Application No. 24079 Permit No. 23325
IN NAME OF

W.M. & MYRA J. HAWLEY

Surveyed MAY 9, 1957, by *Chas. H. Hally*