


T.29S.R.3W.W.M.

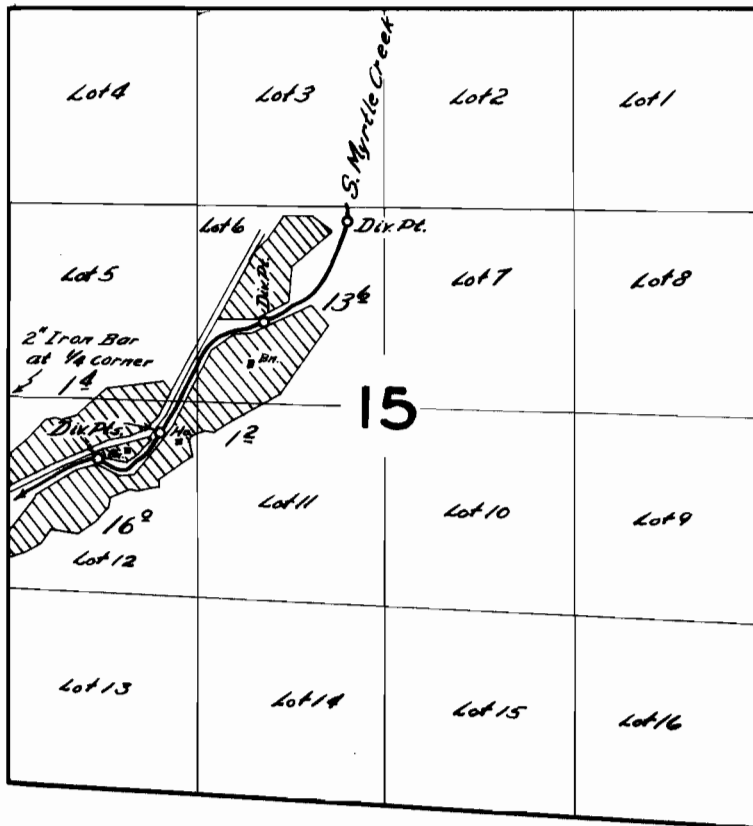

FINAL PROOF SURVEY UNDER

Application No. 28651 Permit No. 23665
IN NAME OF

DONALD L. MAUCK

Surveyed April 13, 1957, by *C.D. Bartels*