


T. 28S. R. 6W. W.M.

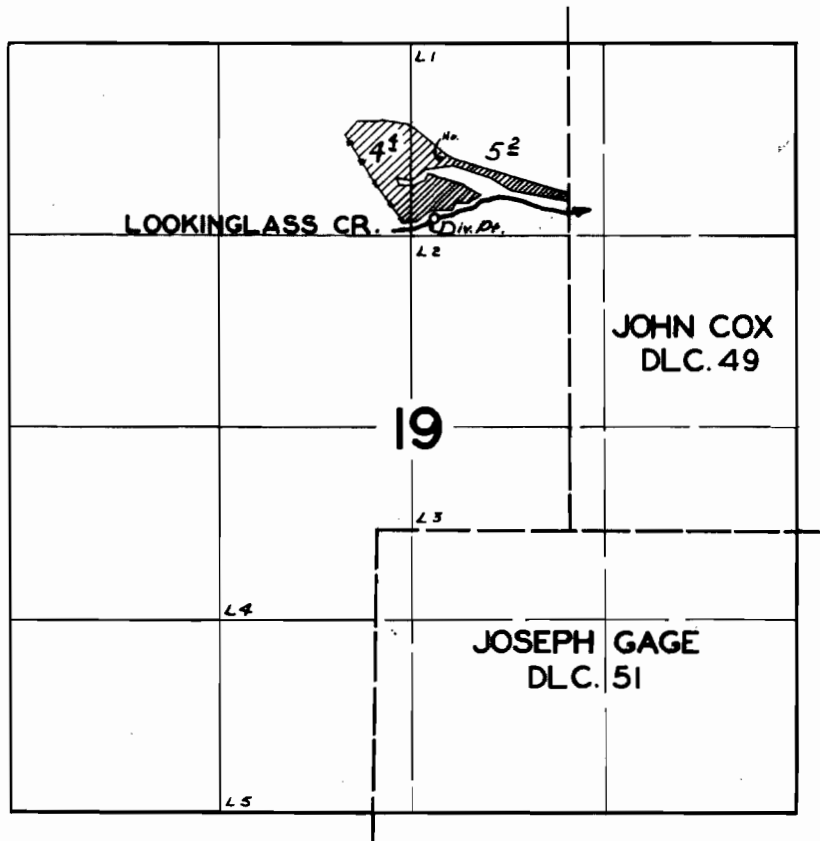

FINAL PROOF SURVEY

UNDER

Application No. 30141 Permit No. 23783

IN NAME OF

C.V. FERGUSON

Surveyed JUNE 27 1957, by C.O. BARTELS