


T. 17S. R. 7W. W.M.

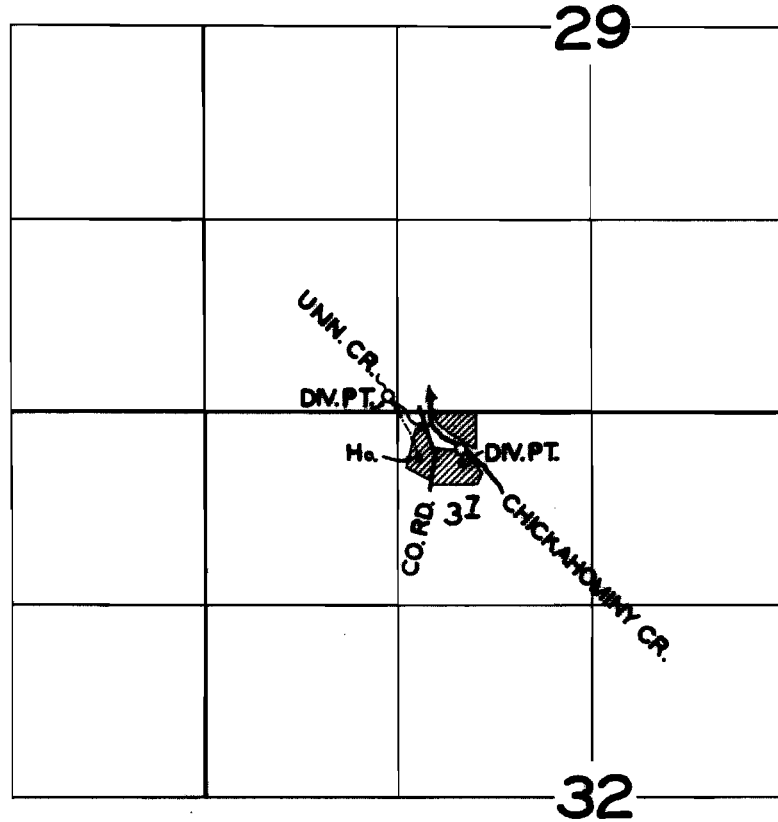

**FINAL PROOF SURVEY**  
UNDER

Application No. 29533 Permit No. 23805  
IN NAME OF

**GERALD R. & AUDREY I. LUNCEFORD**

Surveyed MAY 14 1957, by *[Signature]*