


T. 4 S. R. 1 E. W. W.

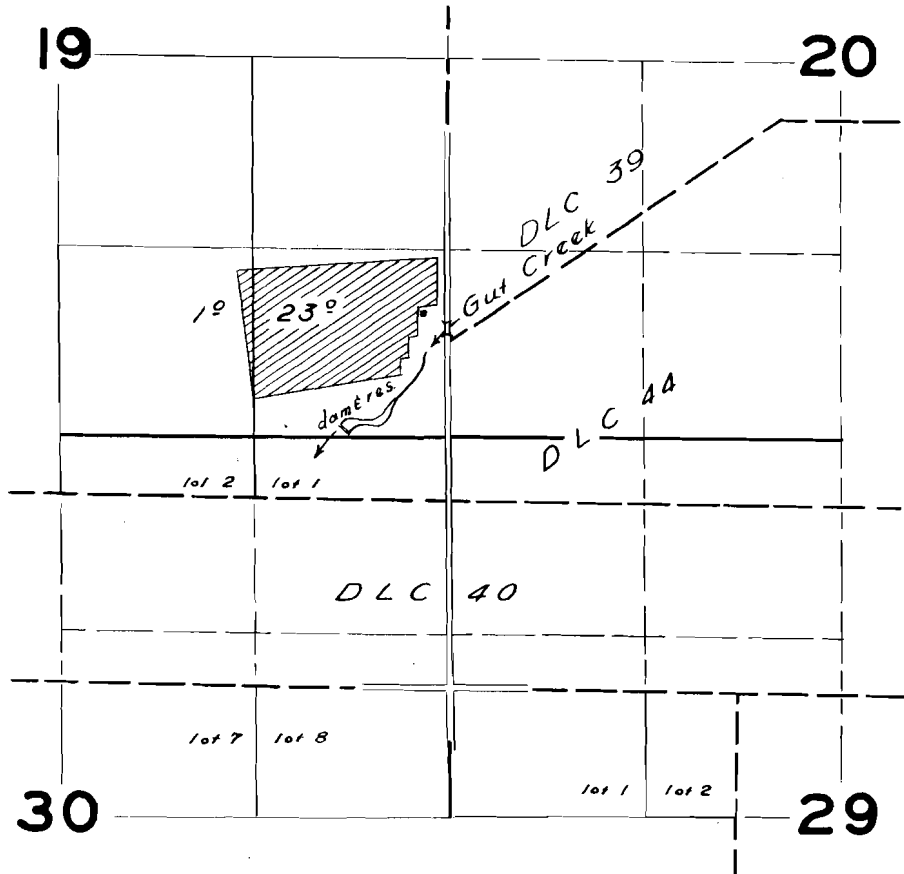

FINAL PROOF SURVEY
UNDER

R-21969 R-855
Application No. 21970 Permit No. 17349
IN NAME OF

FRED JACOBS & A. HESTER

Surveyed 7 July 1957, by *H. L. Coffman*