


T. 8S. R. 2W. W.M.

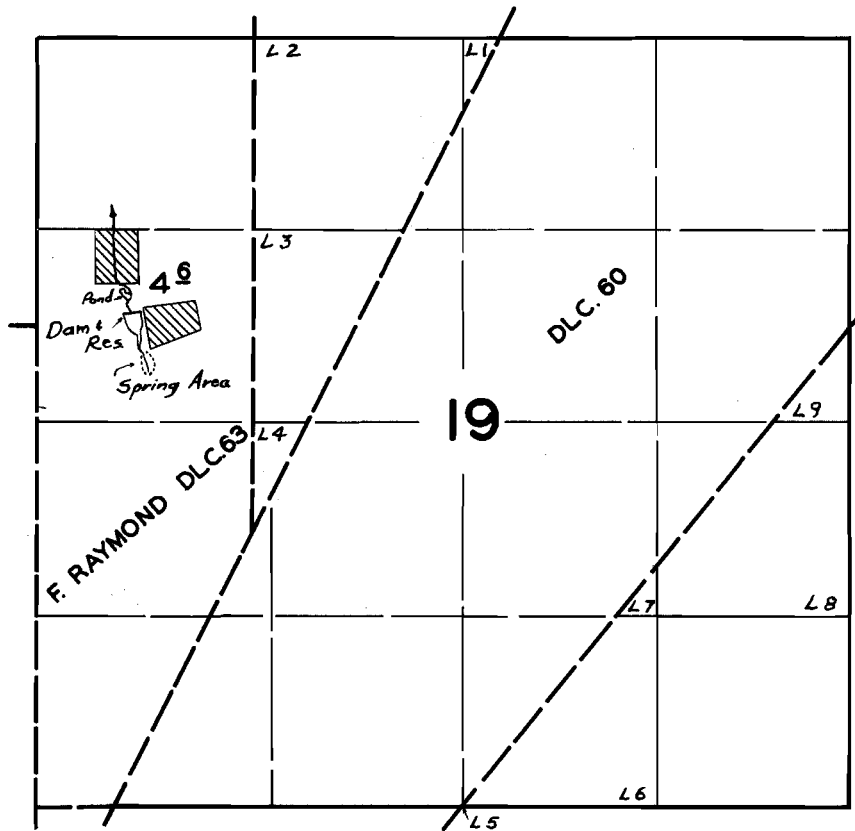

FINAL PROOF SURVEY

UNDER

R-22637

R-888

Application No. 22638 Permit No. 17795...

IN NAME OF

JOHN J. McALLISTER & JOHN J. McALLISTER JR.

Surveyed APR. 4 1957, by C.O. BARTELS