


T.16 S.R.6W.W.M.

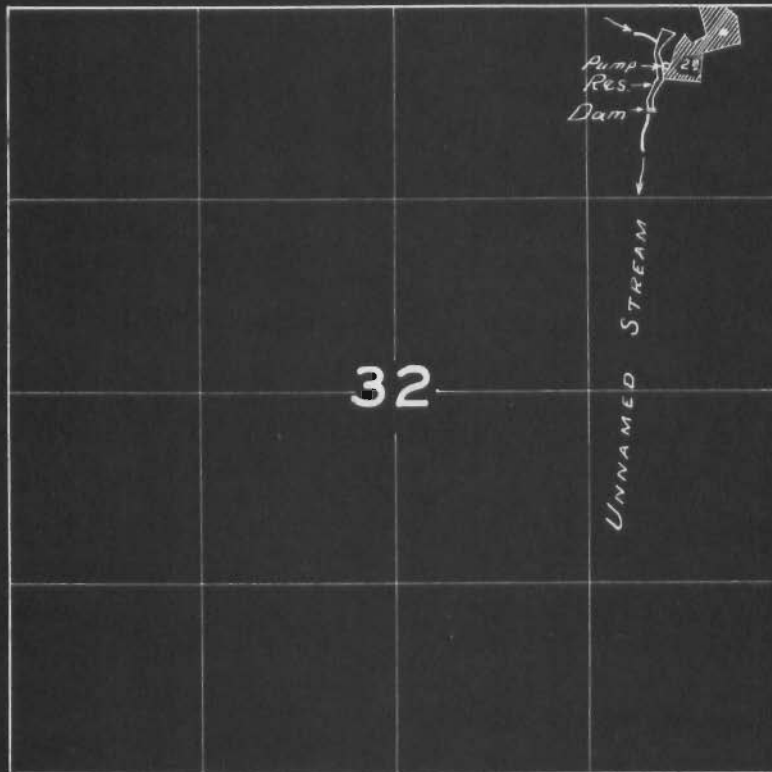

FINAL PROOF SURVEY

UNDER

R-24271

R-1033

Application No. 24272 Permit No. 19446

IN NAME OF

H. F. HALVERSON

Surveyed 17 April 1957, by *C. H. Kitting*