


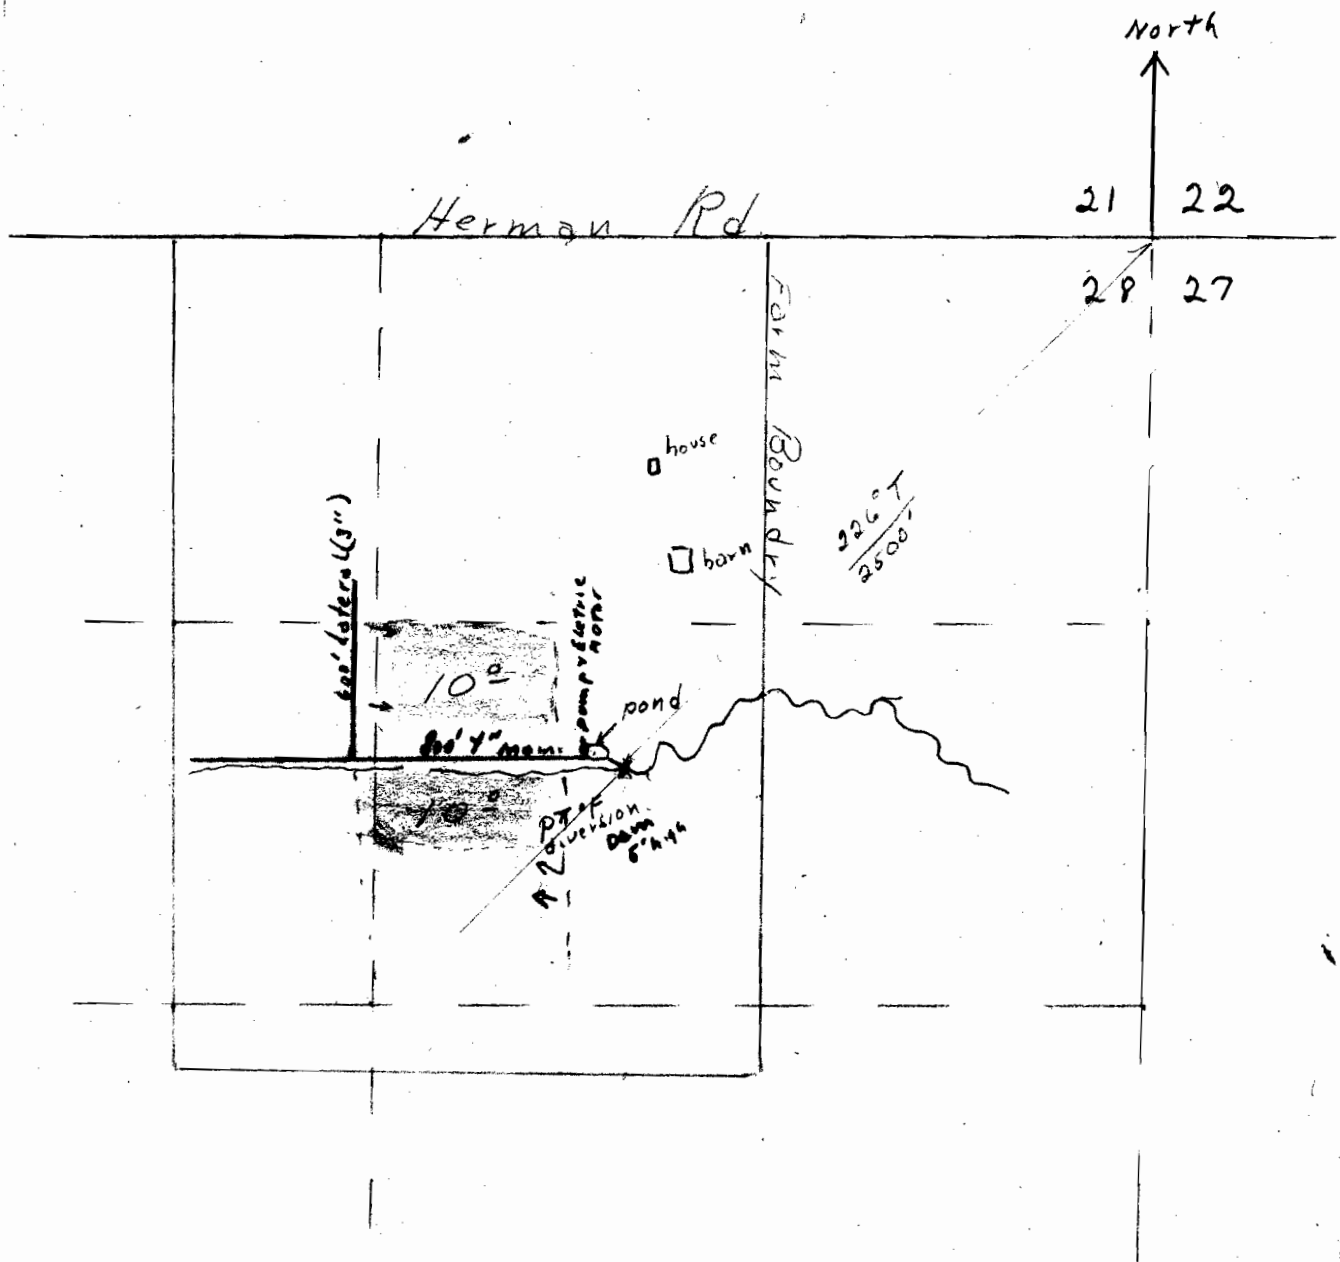

Application No. **R-24479**
 Permit No. **24480**
R-1053
19645

Scale 660 = 1"

TSS
 R2E