


T.5 S. R.2 E.W.M.

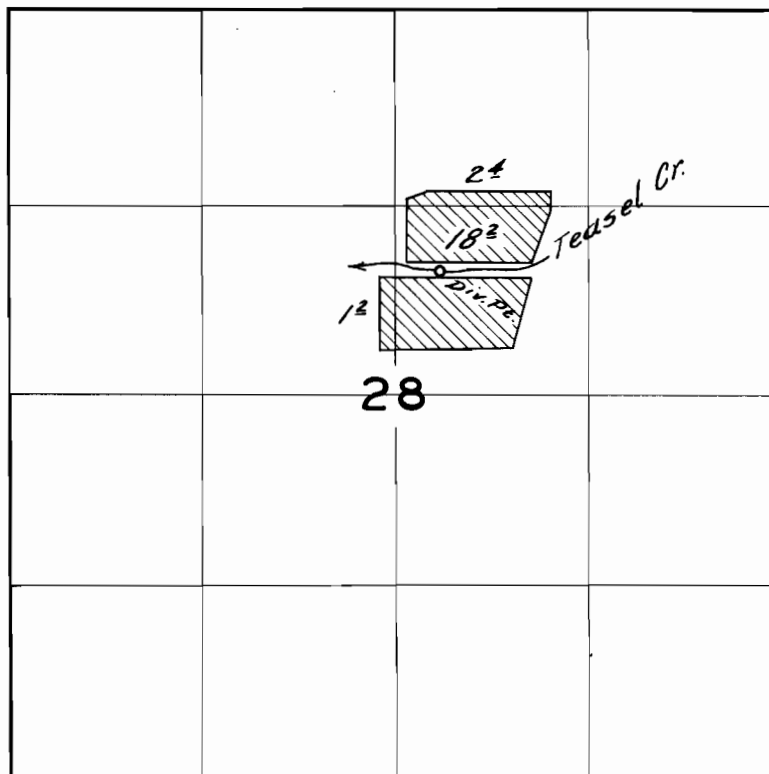

FINAL PROOF SURVEY

UNDER

Application No. 24480 Permit No. 19645
IN NAME OF

ELMER SAWTELL

Surveyed March 29 1956, by R.D. Best

DFK-6D-30

C.B.