


T. 12 S., R. 11 W.W.M.

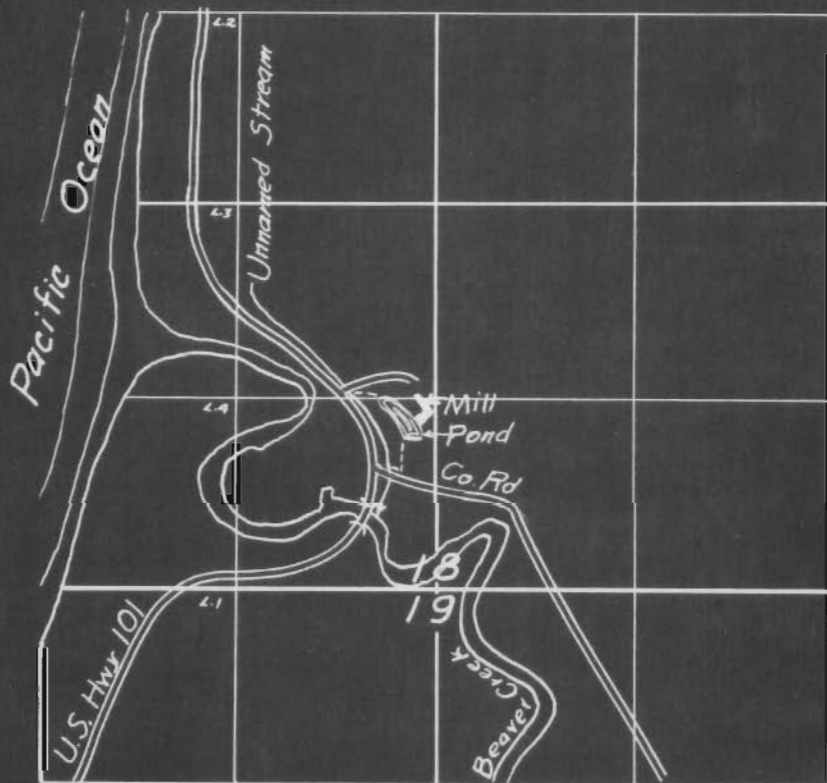

FINAL PROOF SURVEY

UNDER

R-25139

R-1096

Application No. 25140 Permit No. 19951

IN NAME OF

LUNDY BROS. INC.

Surveyed 20 April 1955, by H.L. Coffman