


T.12S., R.11W.M.

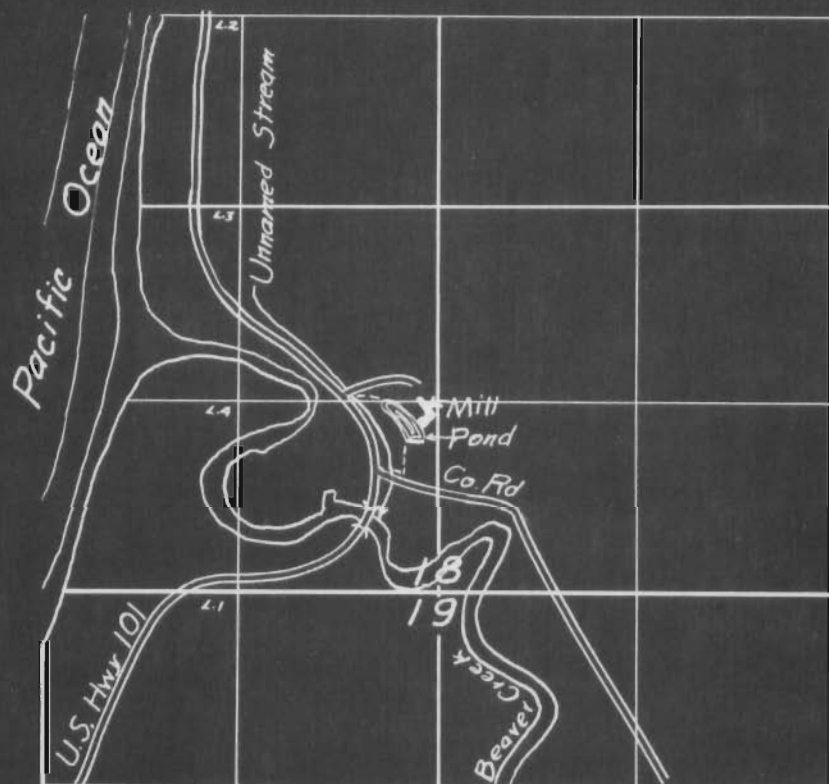

# FINAL PROOF SURVEY

UNDER

R-25139

R-1096

Application No. 25140 Permit No. 19951

IN NAME OF

LUNDY BROS. INC.

Surveyed 20 April 1955, by H.L. Coffman