


T. 4S. R. IW.W.M.

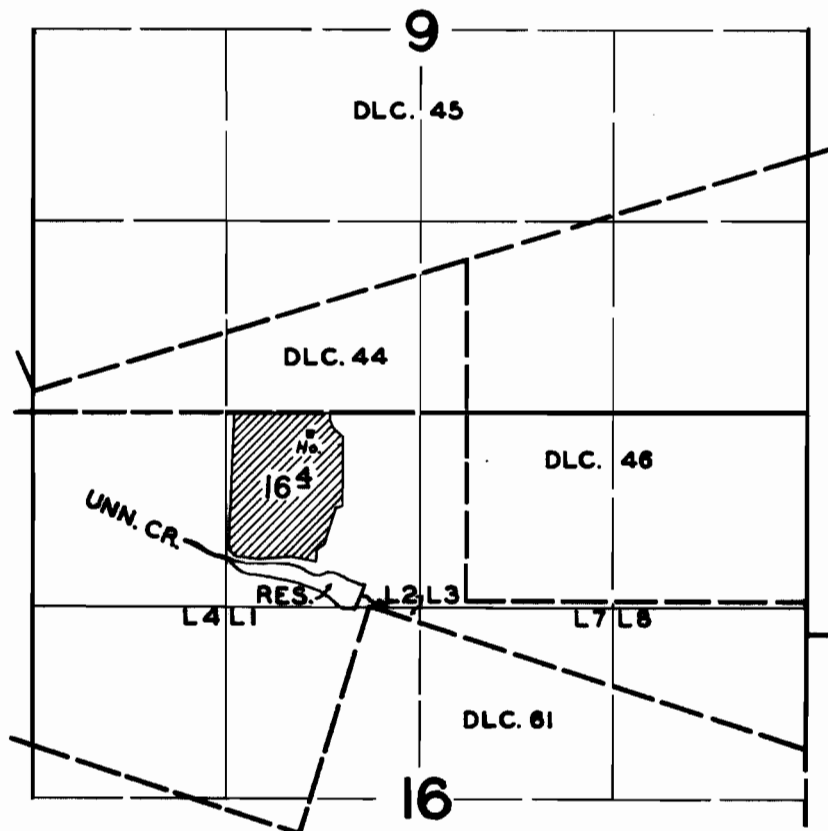

FINAL PROOF SURVEY

UNDER

R-25301 R-1135
Application No. 25302 Permit No. 20211
IN NAME OF

Katherine Martilla

Surveyed SEPT. 4, 1957, by *C.O. Bartels*