


T. 7 S. R. 4 W. W. M.

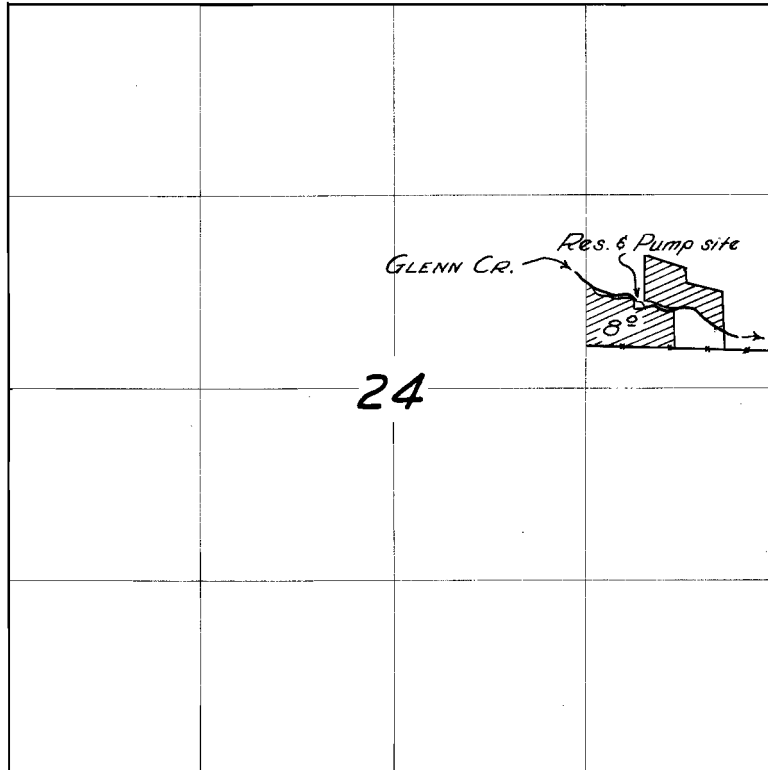

FINAL PROOF SURVEY

UNDER

R-25710

R-1152

Application No. 25711 Permit No. 20252

IN NAME OF

A. A. Withers

Surveyed 18 Mar. 1957, by [Signature]